



T18S, R18E, Sec 10, NW 1/4 NW 1/4

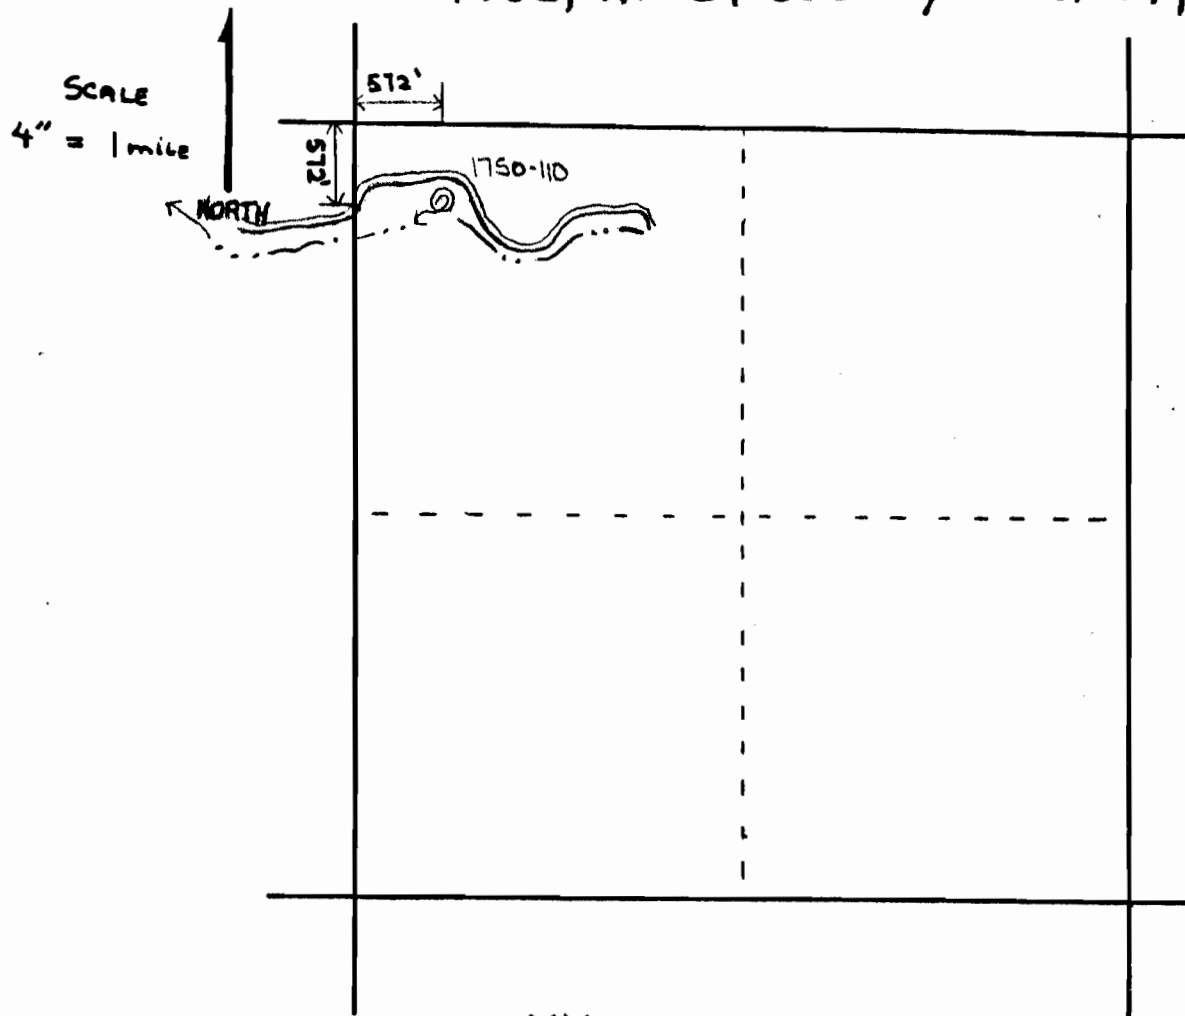

NYE SPRING

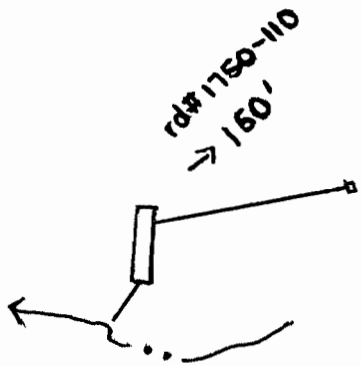



Scale

1 inch = 40 feet

Application No. 67793
Permit No.

SCALE
4" = 1 mile

NORTH

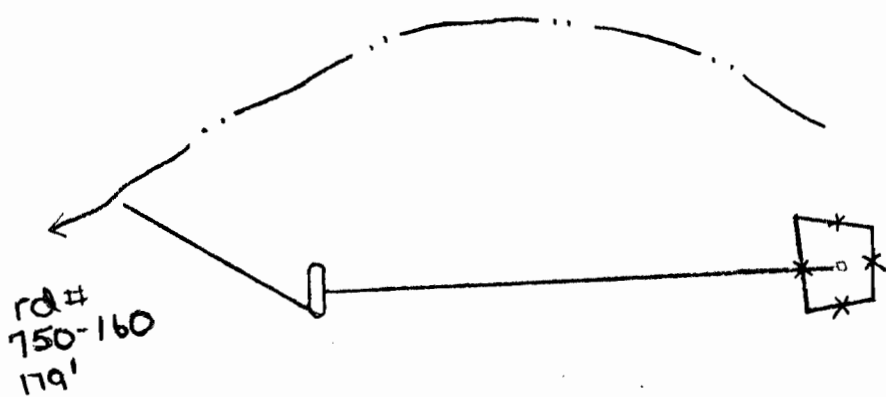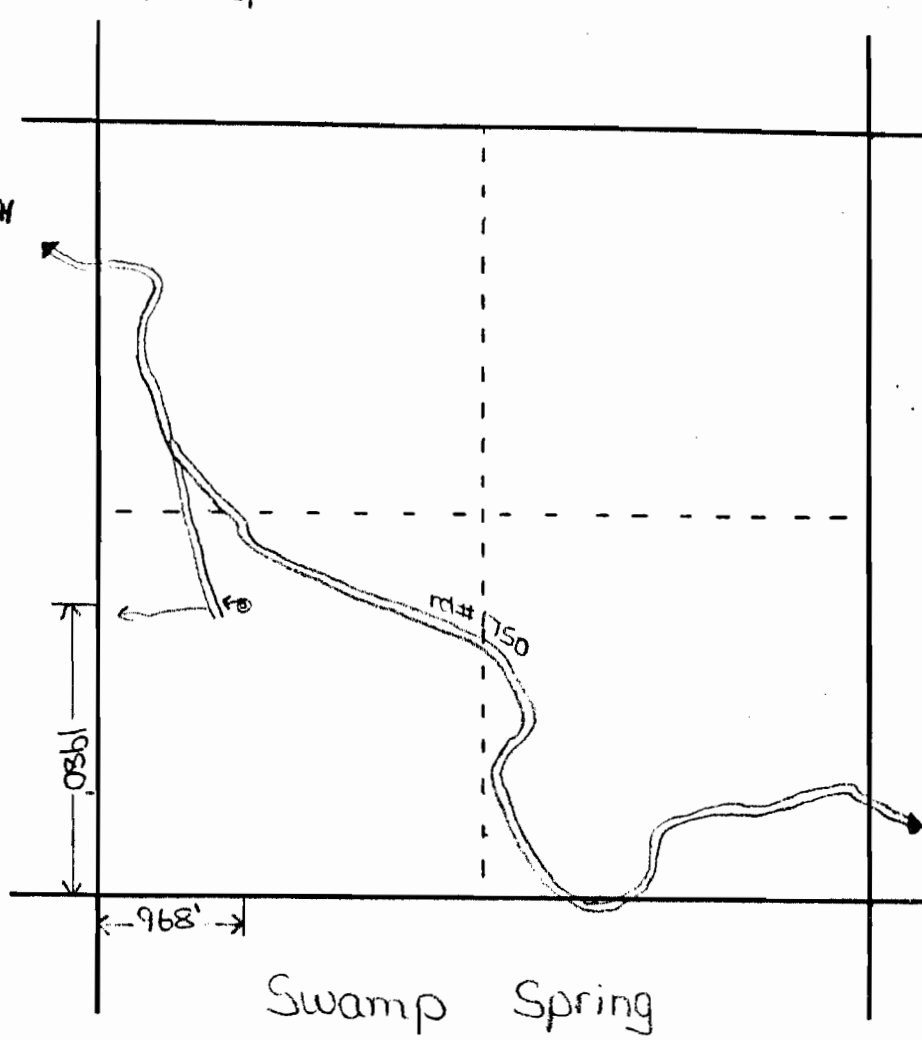

Scale

1 inch = 40 feet

Application No. 67793
Permit No. 51327