


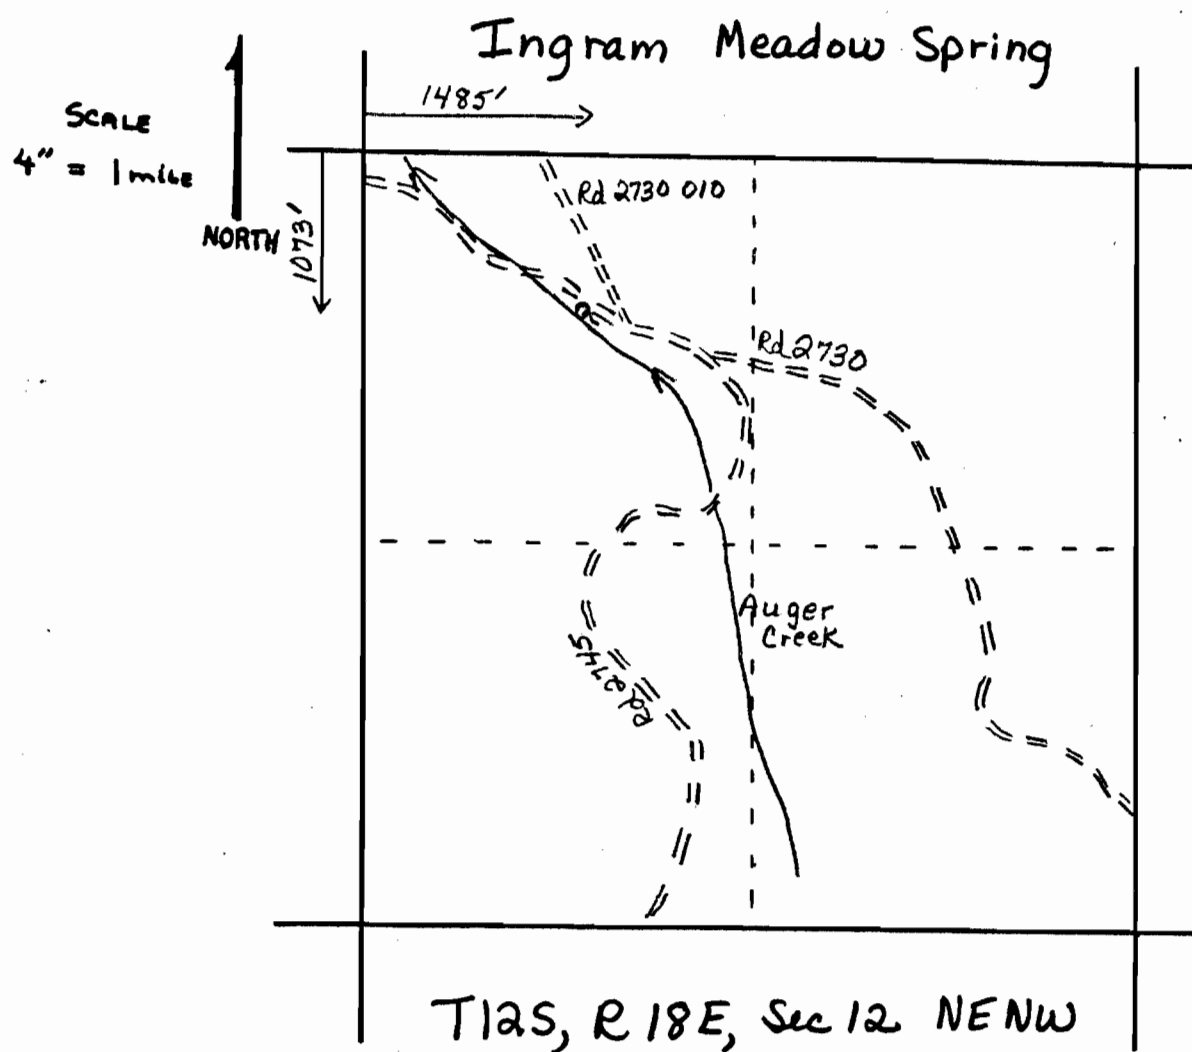

Application No. 67794
Permit No. 51328

