



T18S, R18E, Sec 2, NW 1/4 SW 1/4, WM

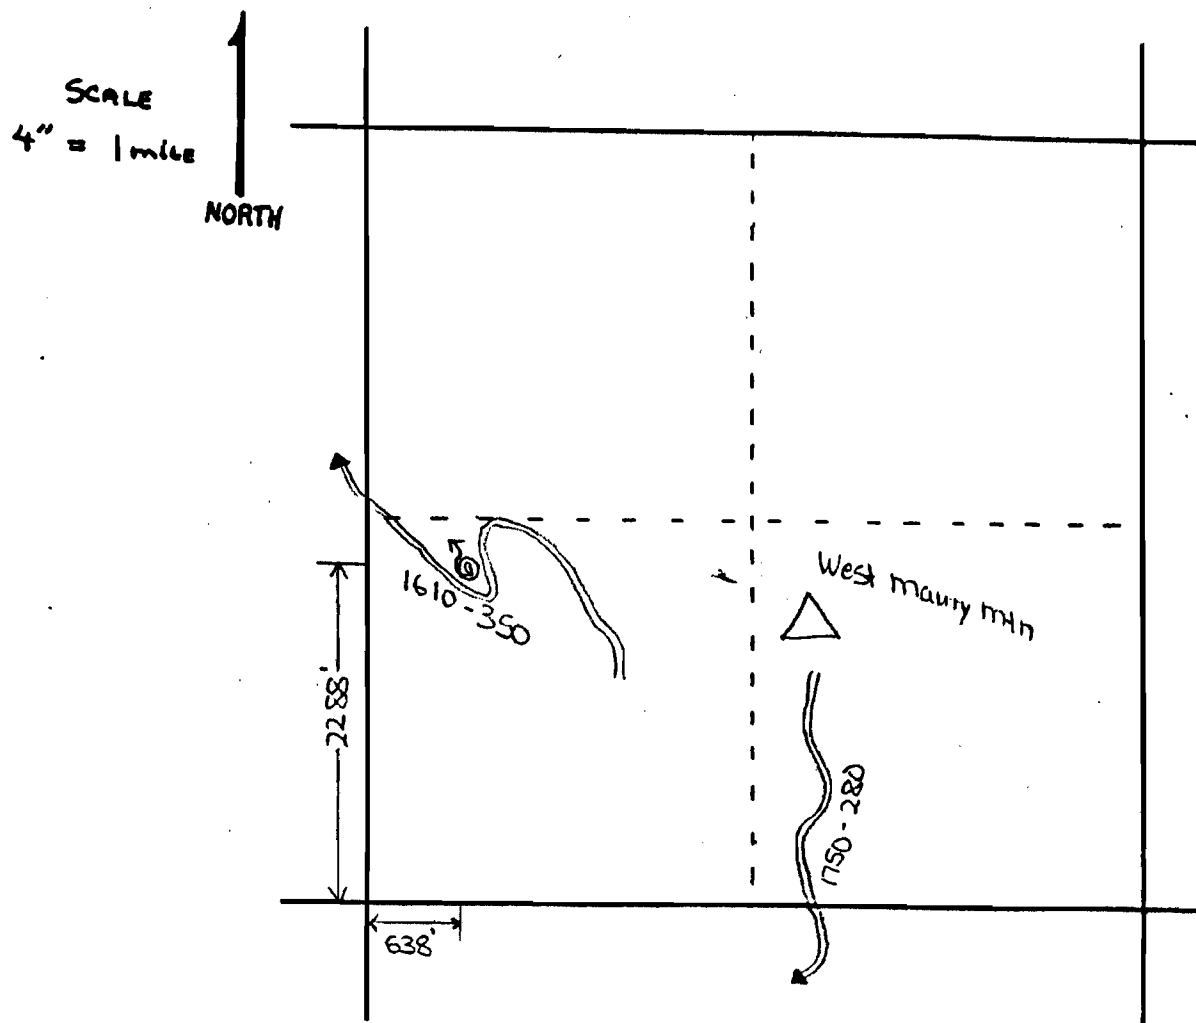

Skeleton Spring

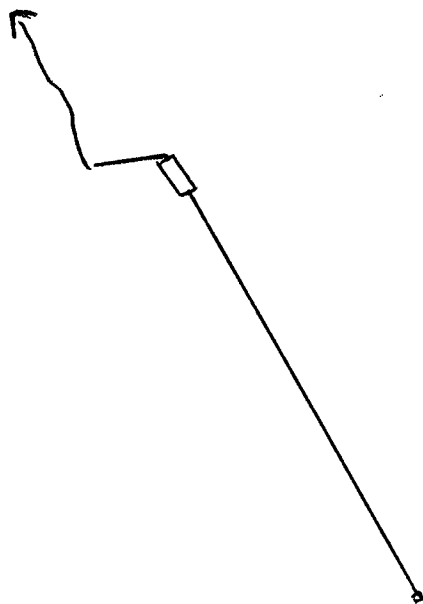

Scale
1 inch = 40 feet

Application No. 67795
Permit No. 51329