
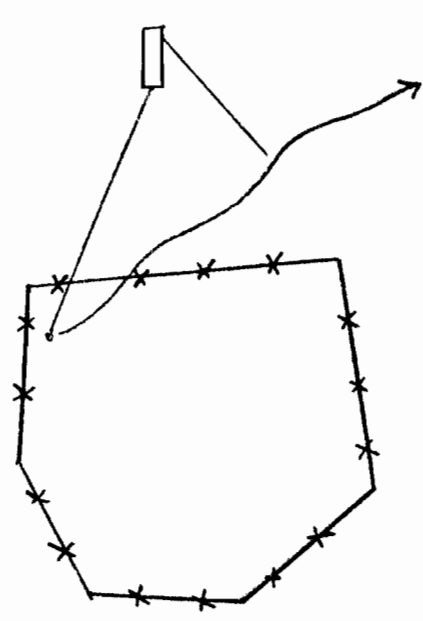


T12S, R17E, Sec 1, NE 1/4 SW 1/4, WM

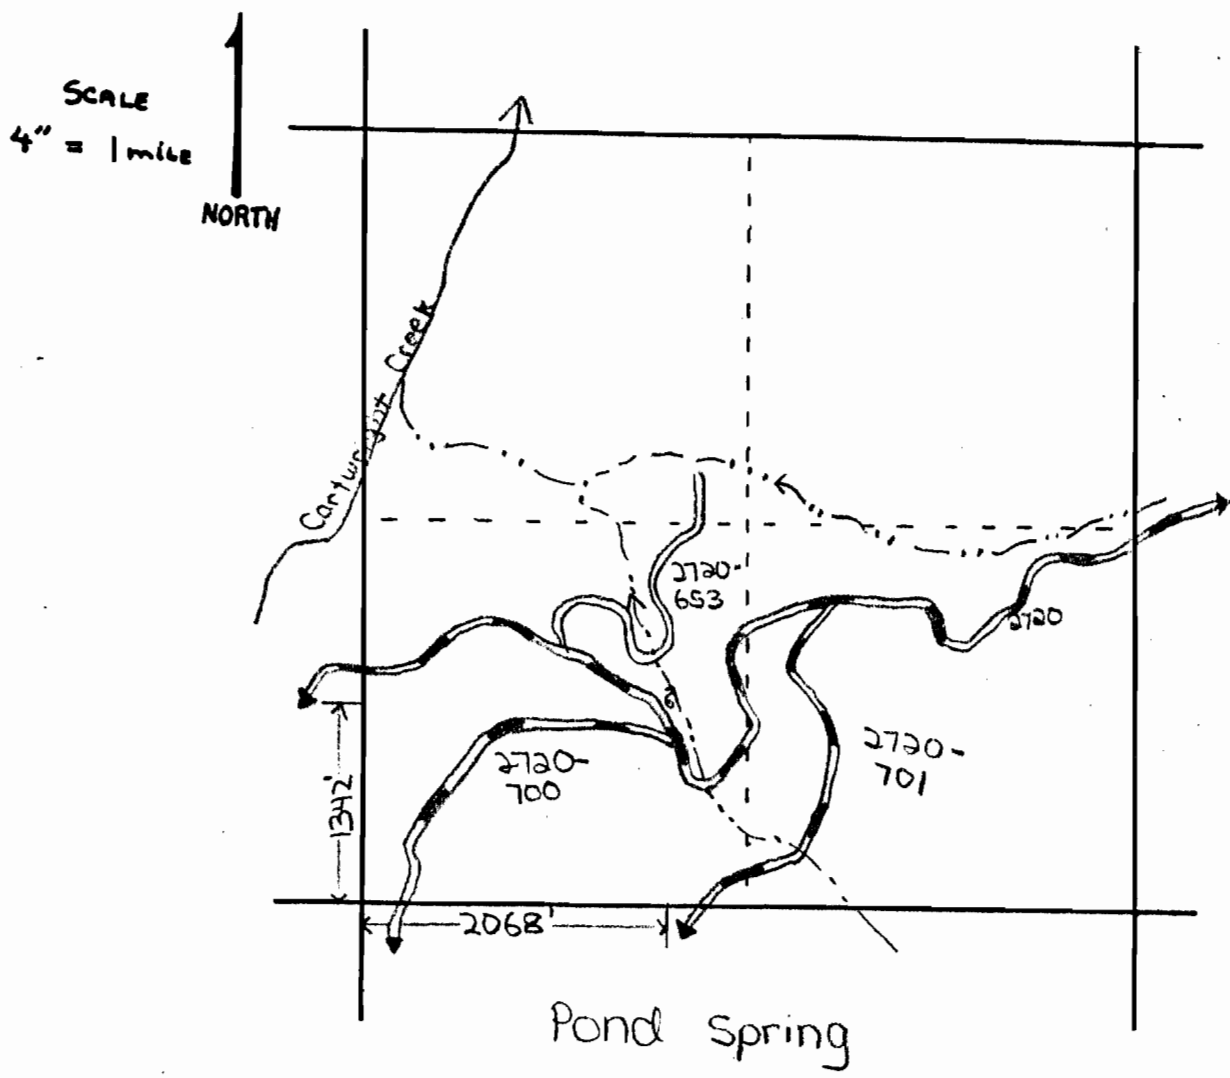

Scale
1 inch = 40 feet

Application No. 67796
Permit No. 51330