
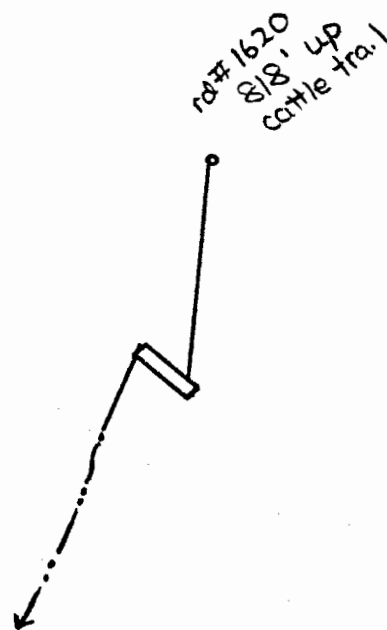


T 17S, R 18E, Sec 33, NW 1/4 NW 1/4, W 1/4

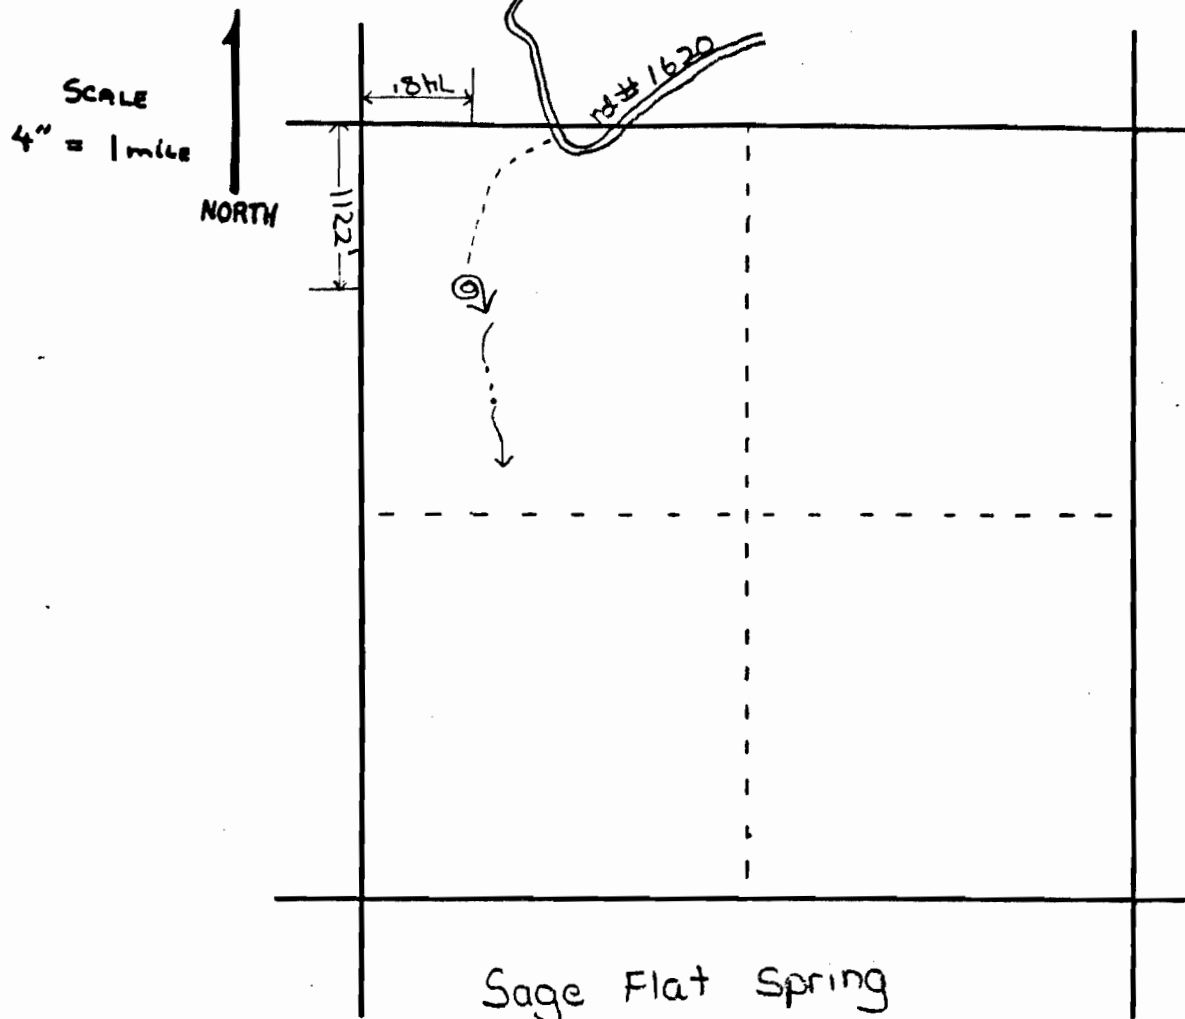

Scale

1 inch = 40 feet

Application No. 67797
Permit No. 51331