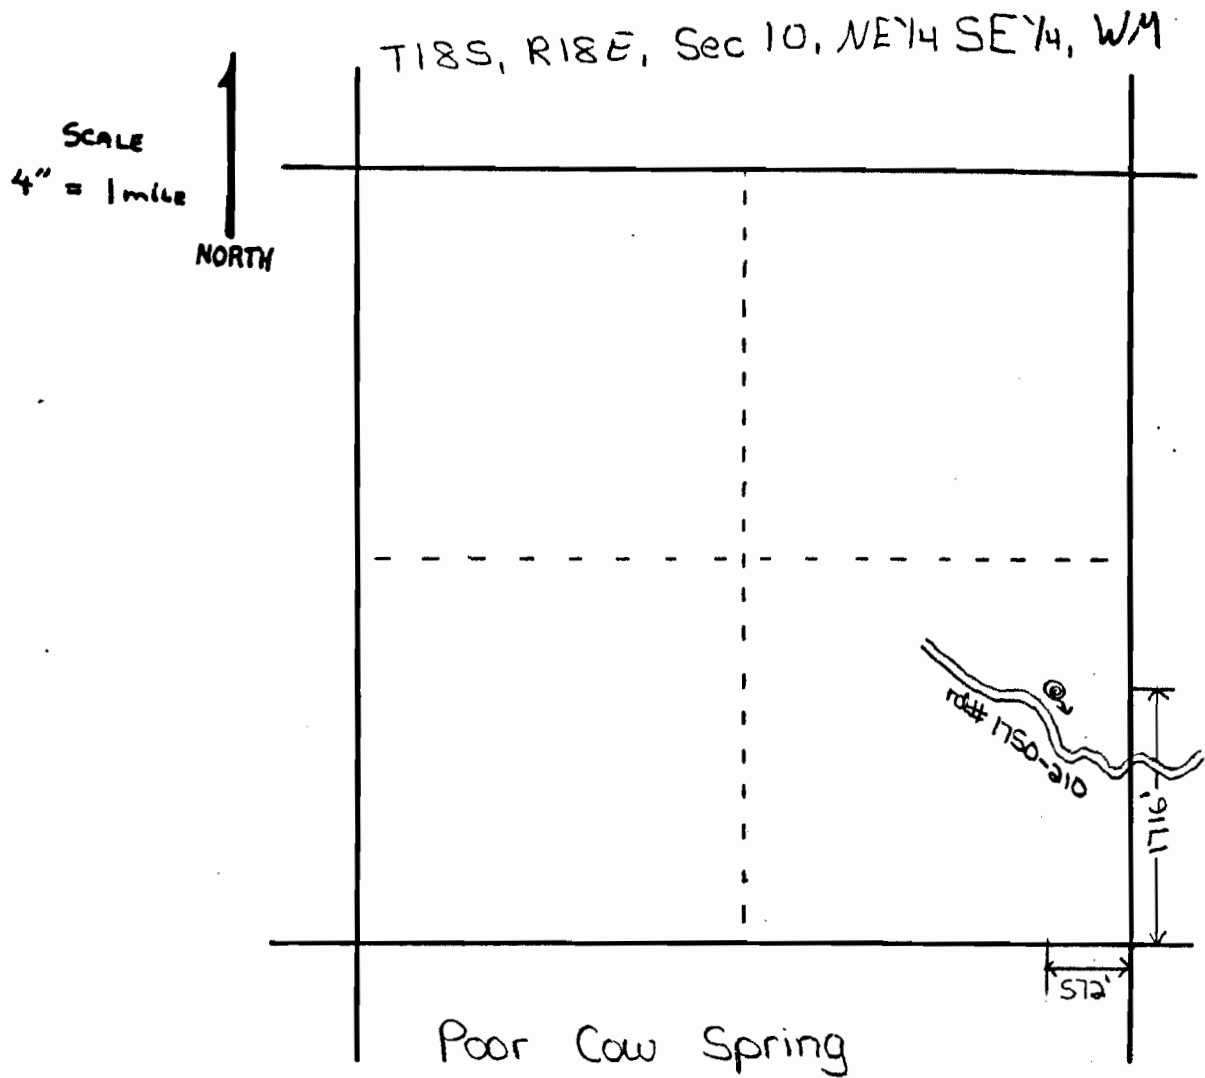


Scale


← 01C-05LI #20

Application No. 67798
Permit No. 51332