



T18S, R18E, Sec 11, NW 1/4 NE 1/4
WM

SCALE
4" = 1 mile

NORTH

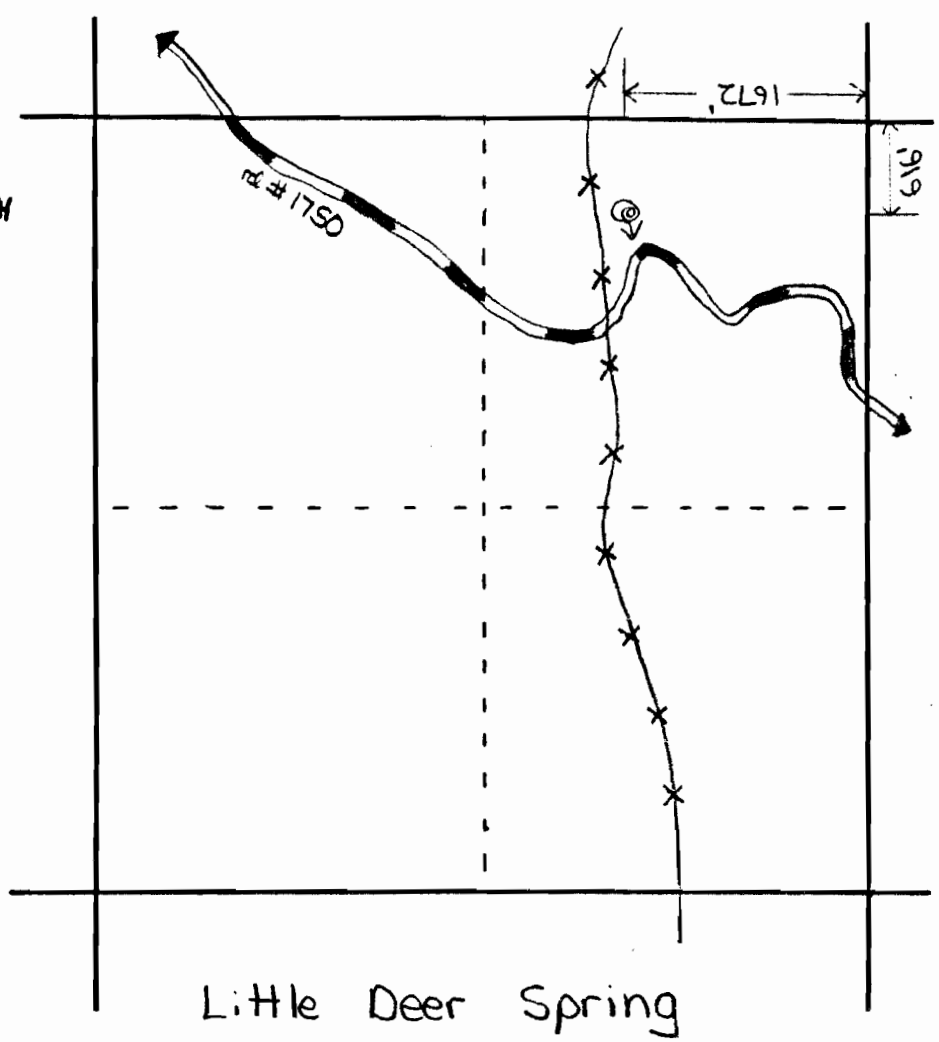

Application No. 67799
Permit No. 51333

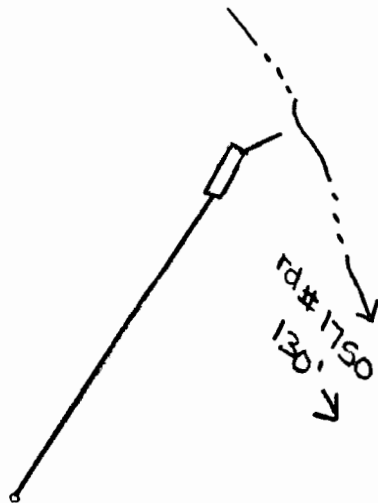

Scale
1 inch = 40 feet