
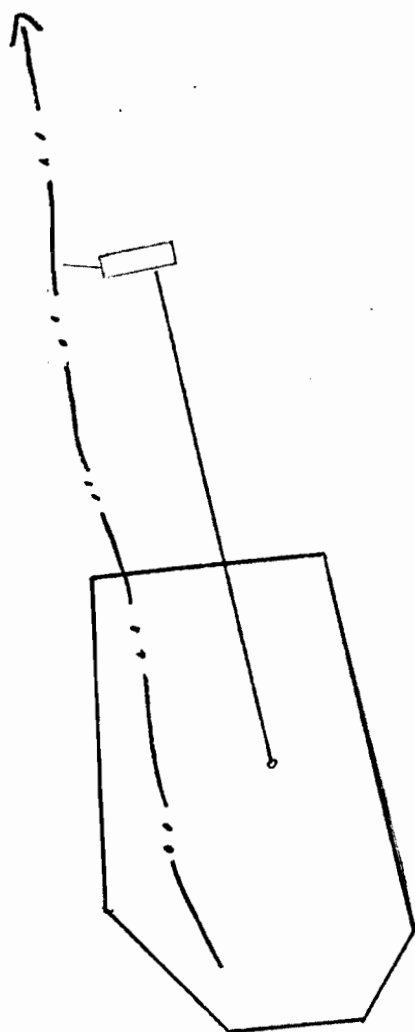


T18S, R19E, Sec 5, NE 1/4 NW 1/4, WM

SCALE
4" = 1 mile

NORTH

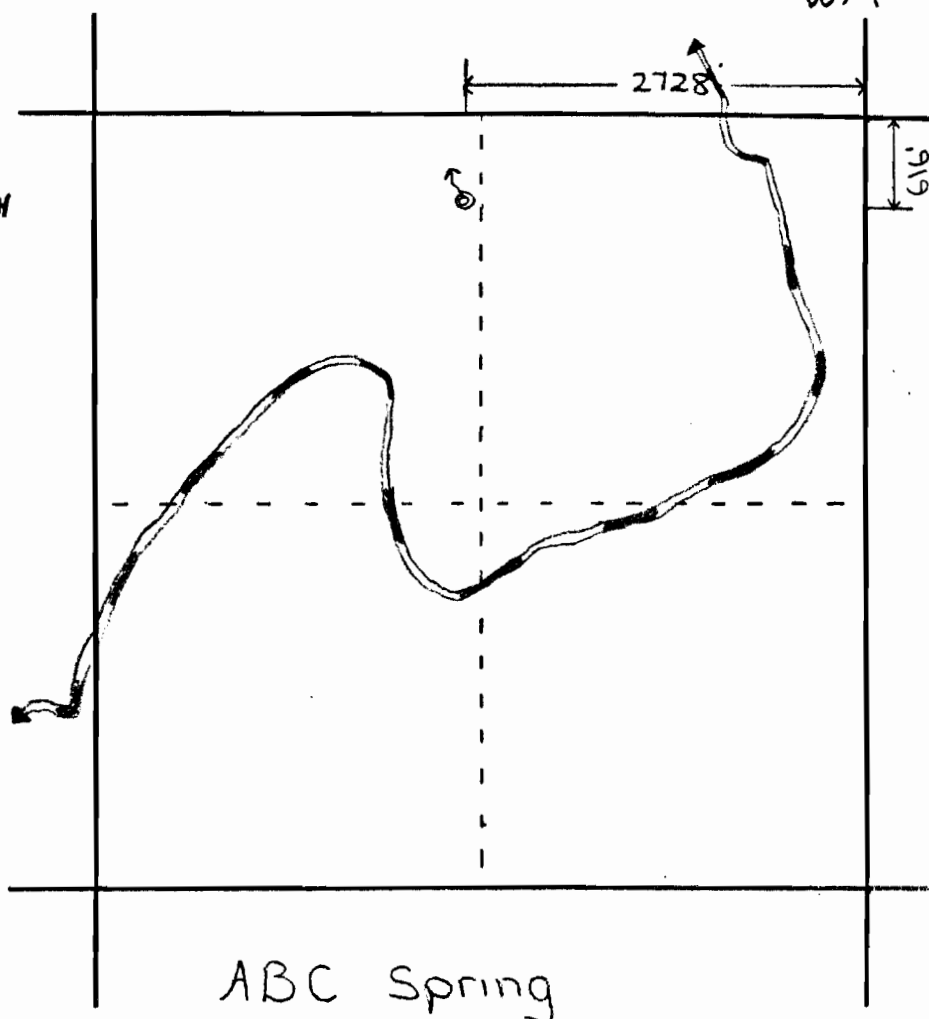

Scale
1 inch = 40 feet

Application No. 67800
Permit No. 51334