


T. 3 S., R. 41 E., W.M.

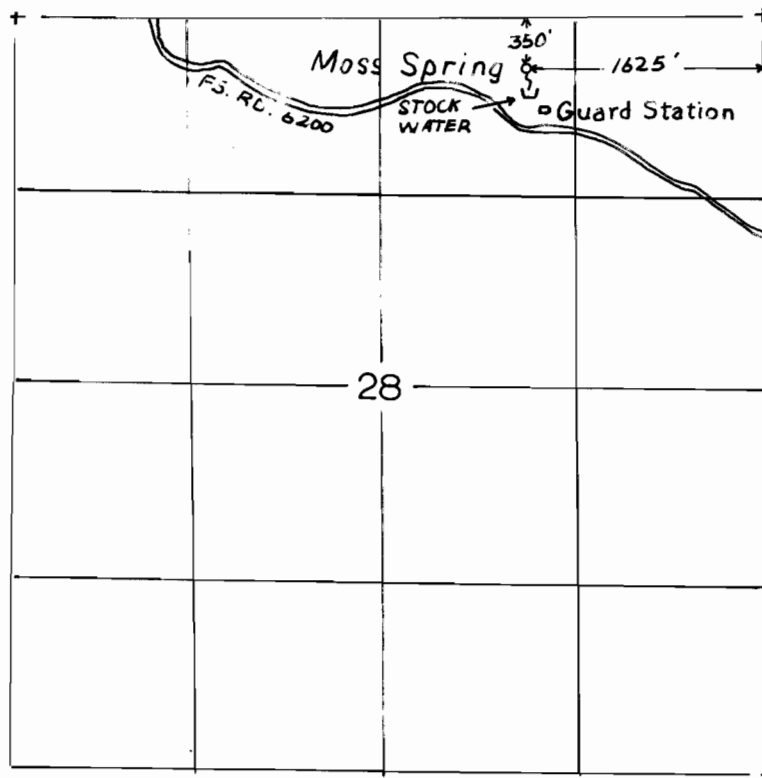

FINAL PROOF SURVEY
UNDER

Application No. 39888 Permit No. 30037
IN NAME OF:

U. S. DEPARTMENT OF AGRICULTURE, WALLOWA WHITMAN N.F.

Surveyed 7-16, 1991, by J. MILLER