


SEP 11 1981

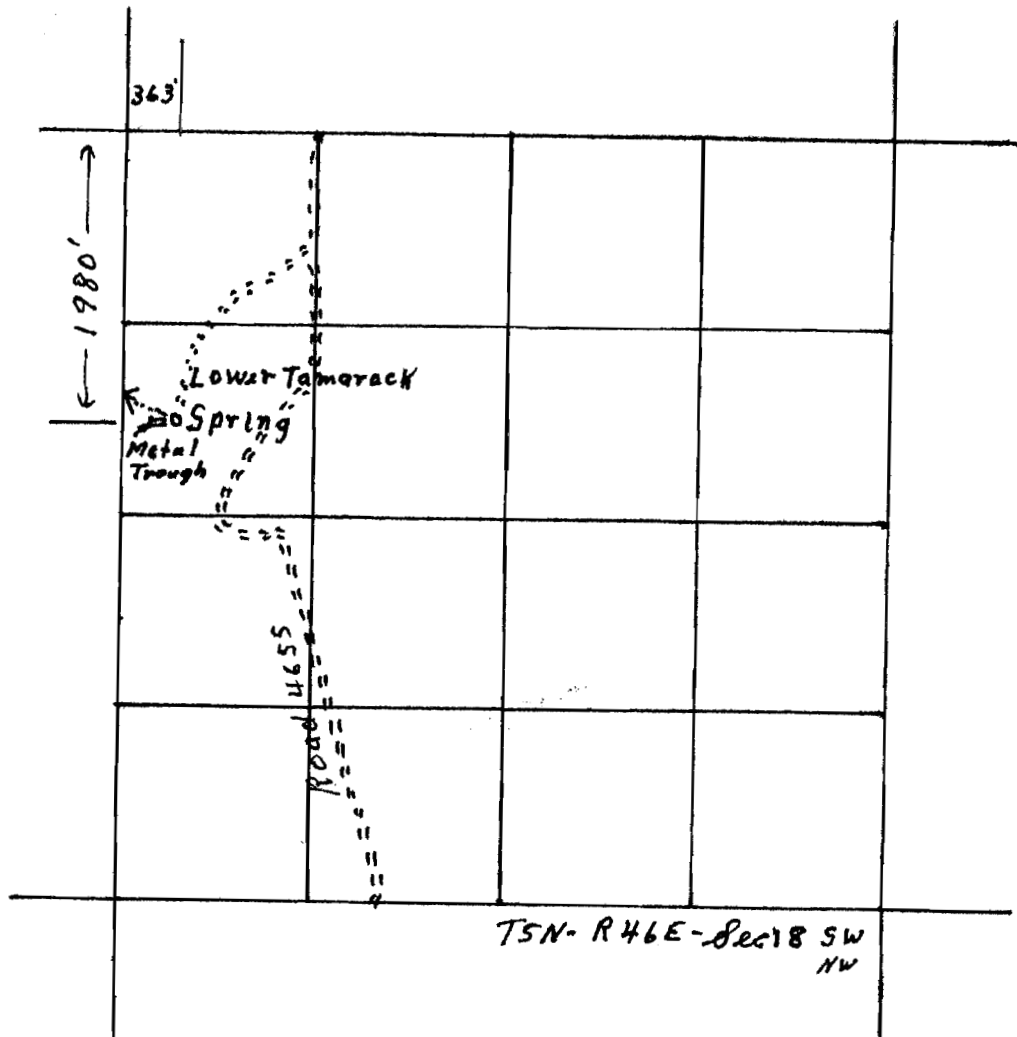

Permit No. 46725

4 inches = 1 mile