


RECEIVED

SEP 11 1981

WATER RESOURCES DEPT
SALEM, OREGON

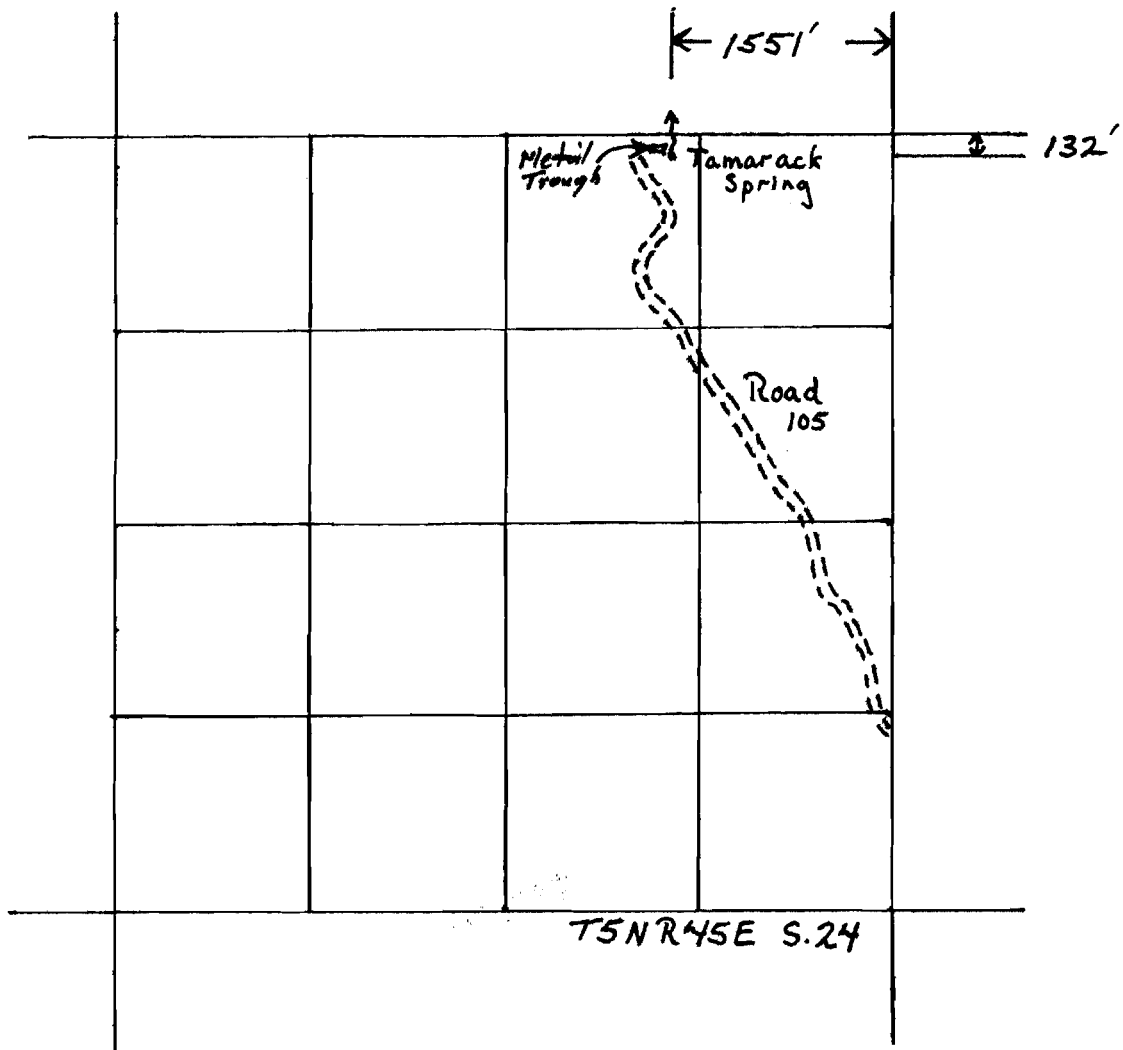

Application No. 62649
Permit No. 46727

4 inches = 1 mile