RECEIVED
SEP 11 1981
WATER RESOURCES DEPT
SALEM, OREGON

N

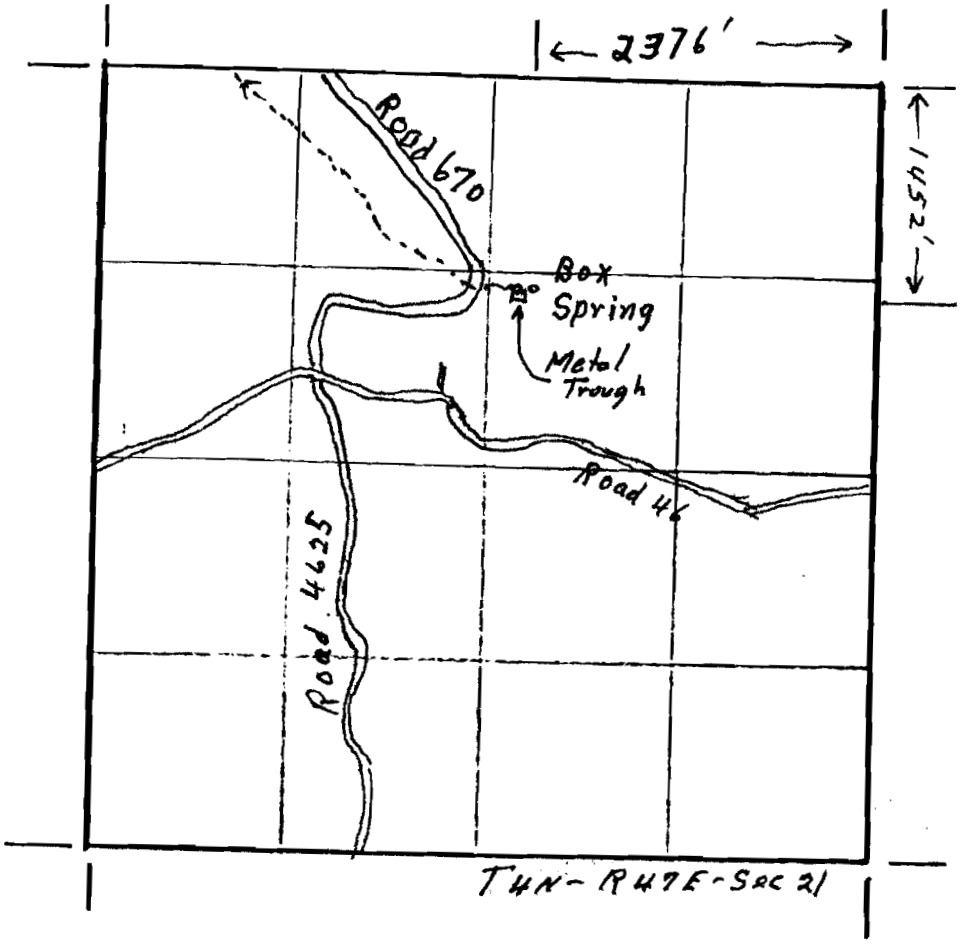

4 Inches = 1 Mile

Application No. G2650
Permit No. 46728