


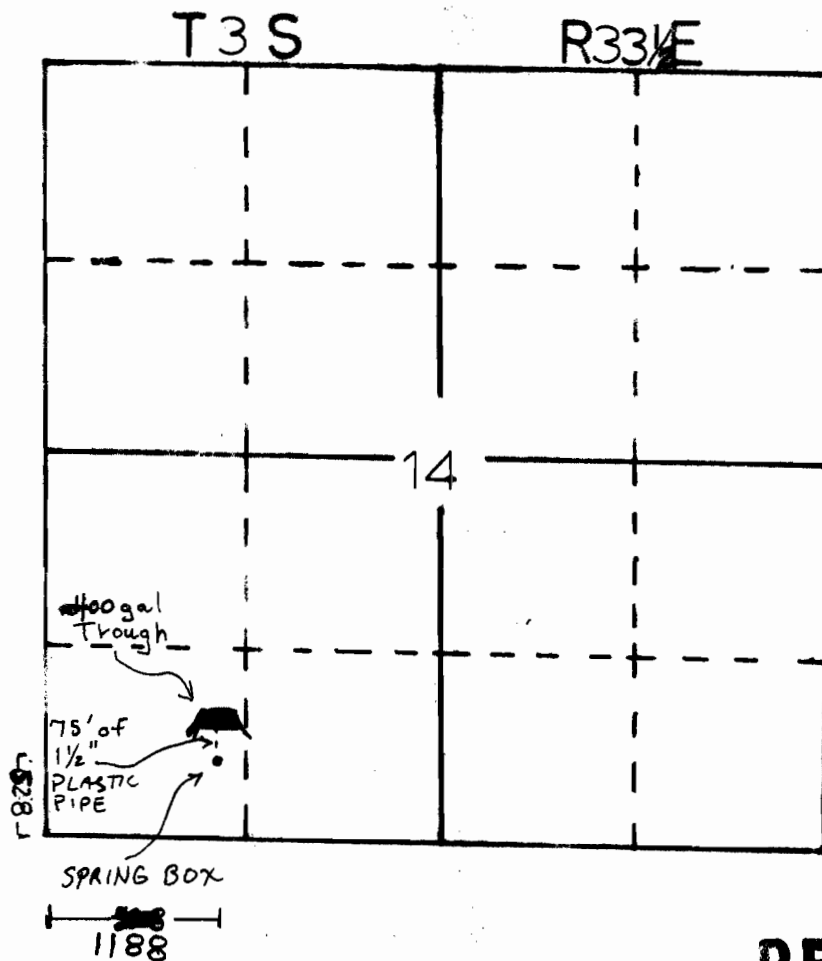

Application No. 66304
Permit No. 48557

RECEIVED
DEC 27 1983
WATER RESOURCES DEPT.
SALEM, OREGON

RECEIVED
SEP 19 1983
WATER RESOURCES DEPT.
SALEM, OREGON