


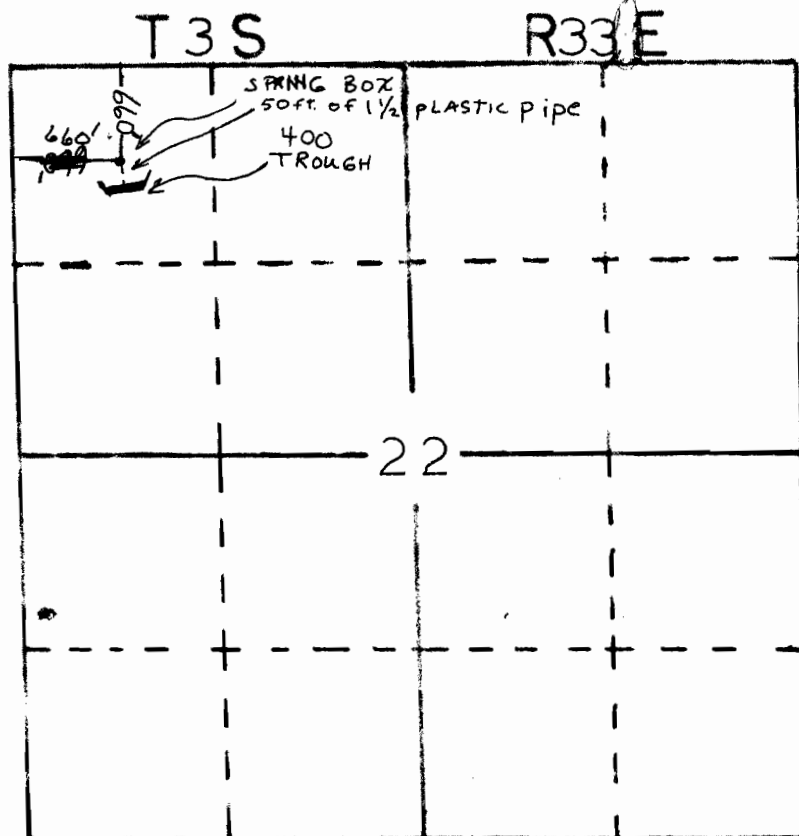

Application No. 66305
 Permit No. 48558

ED
 SEP 29 1983
 UTILITIES DEPT.
 SALEM, OREGON