


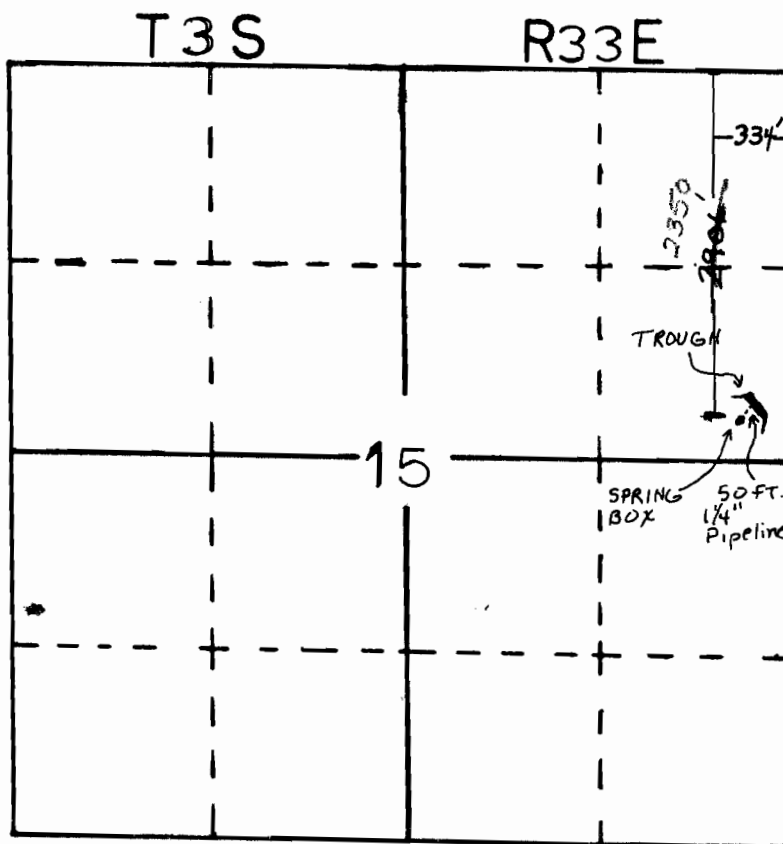

RECEIVED

DEC 2 1982

WATER RESOURCES DEPT.
SALEM, OREGON

66306

48559

AD

SEP 9 1983

WATER RESOURCES DEPT.
SALEM, OREGON