


N

Application No. 66317
Permit No. 48567

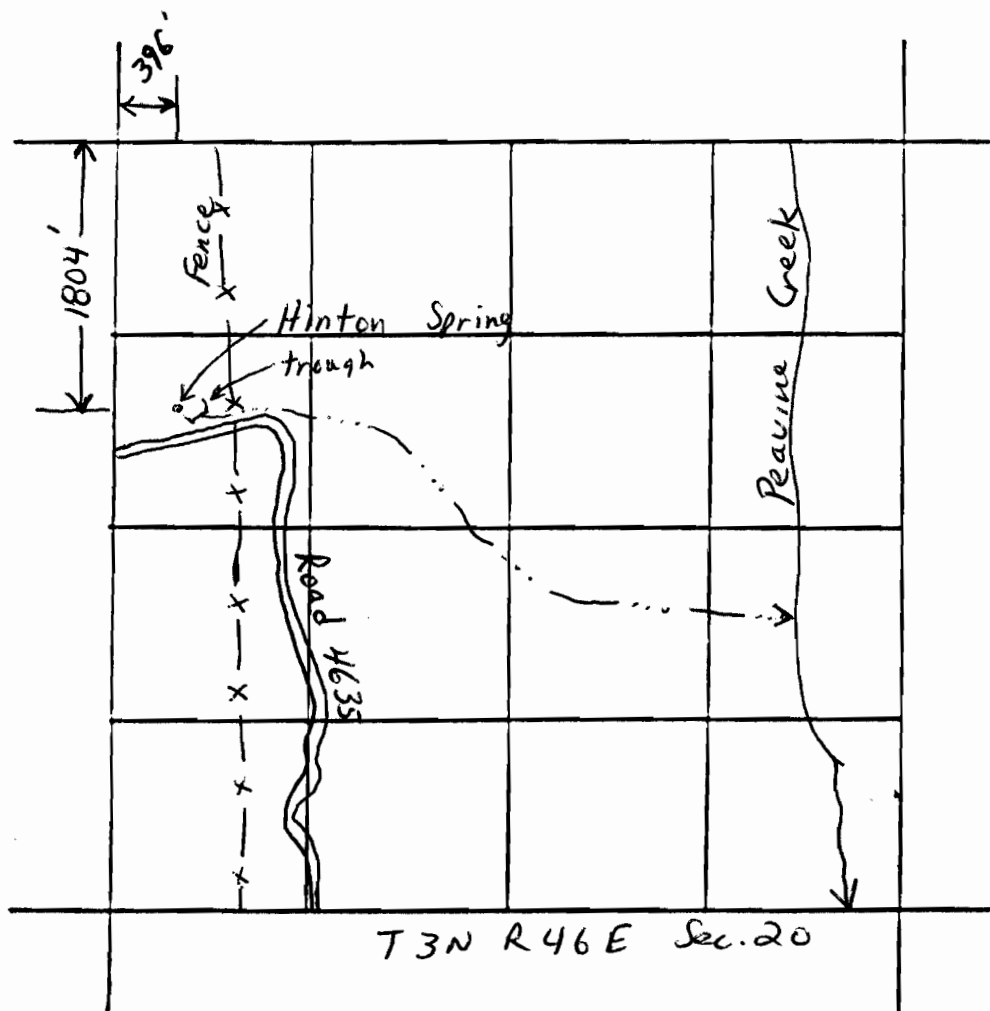

4 inches = 1 mile

RECEIVED
SEP. 9 1933
LAND OFFICES DEPT.
SALEM, OREGON