


Application No. 603856
Permit No. 48589

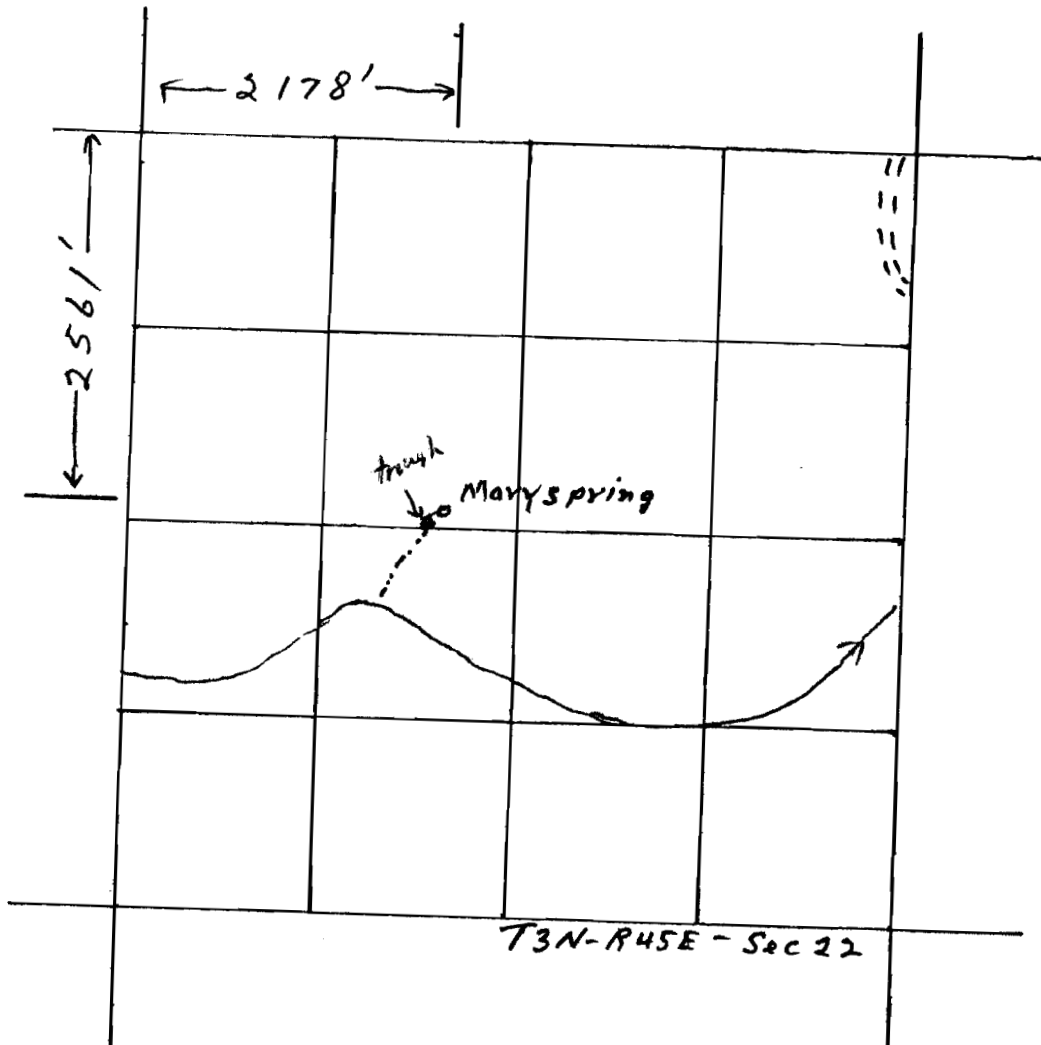

RECEIVED

AUG 19 1982

WATER RESOURCES DEPT.
SALEM, OREGON

4 inches = 1 mile