


Application No. 63857
Permit No. 48590
N

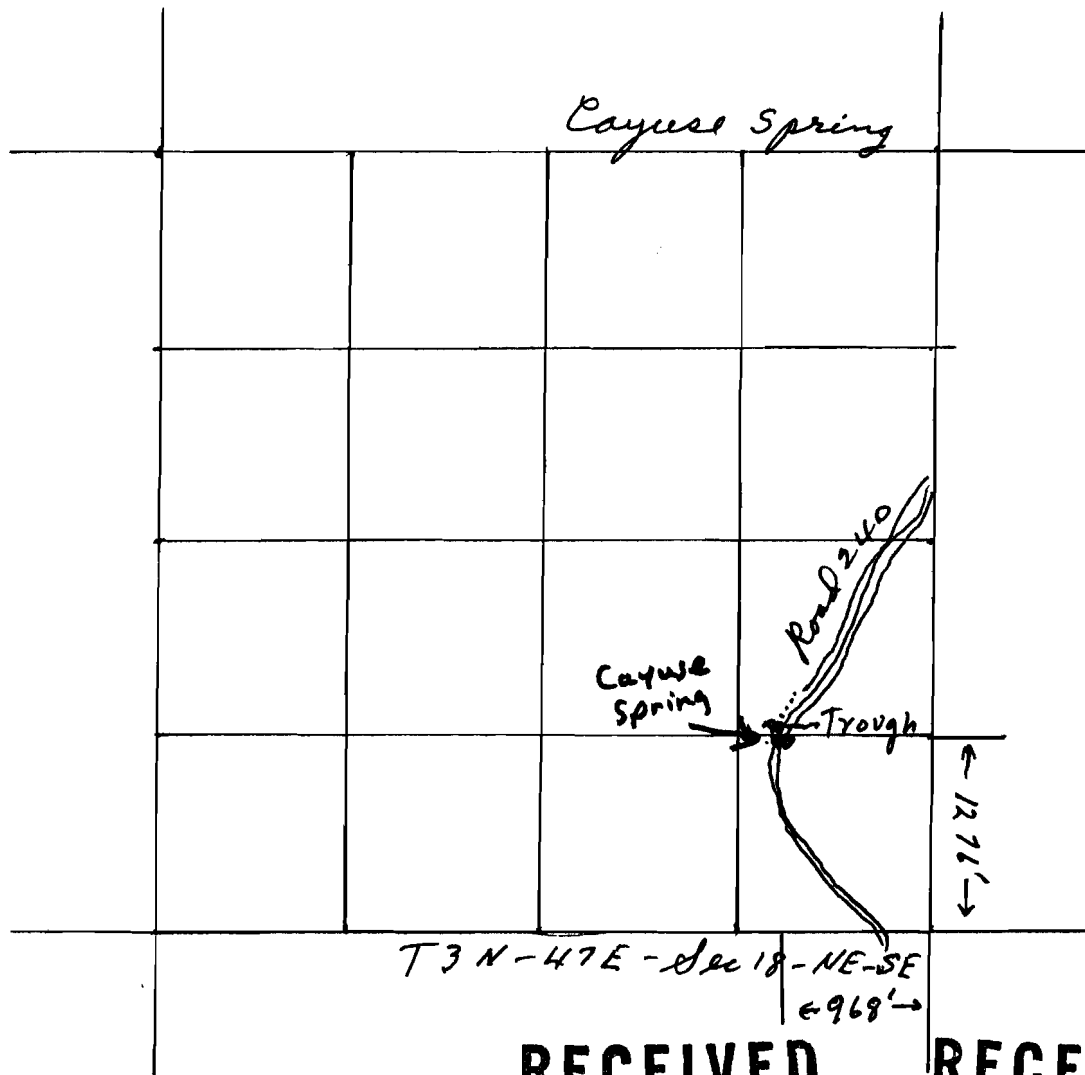

RECEIVED

APR 6 1983

WATER RESOURCES DEPT.
SALEM, OREGON

RECEIVED

AUG 19 1982

WATER RESOURCES DEPT.
SALEM, OREGON

4 inches = 1 mile