


Application No. 63858
Permit No. 48591

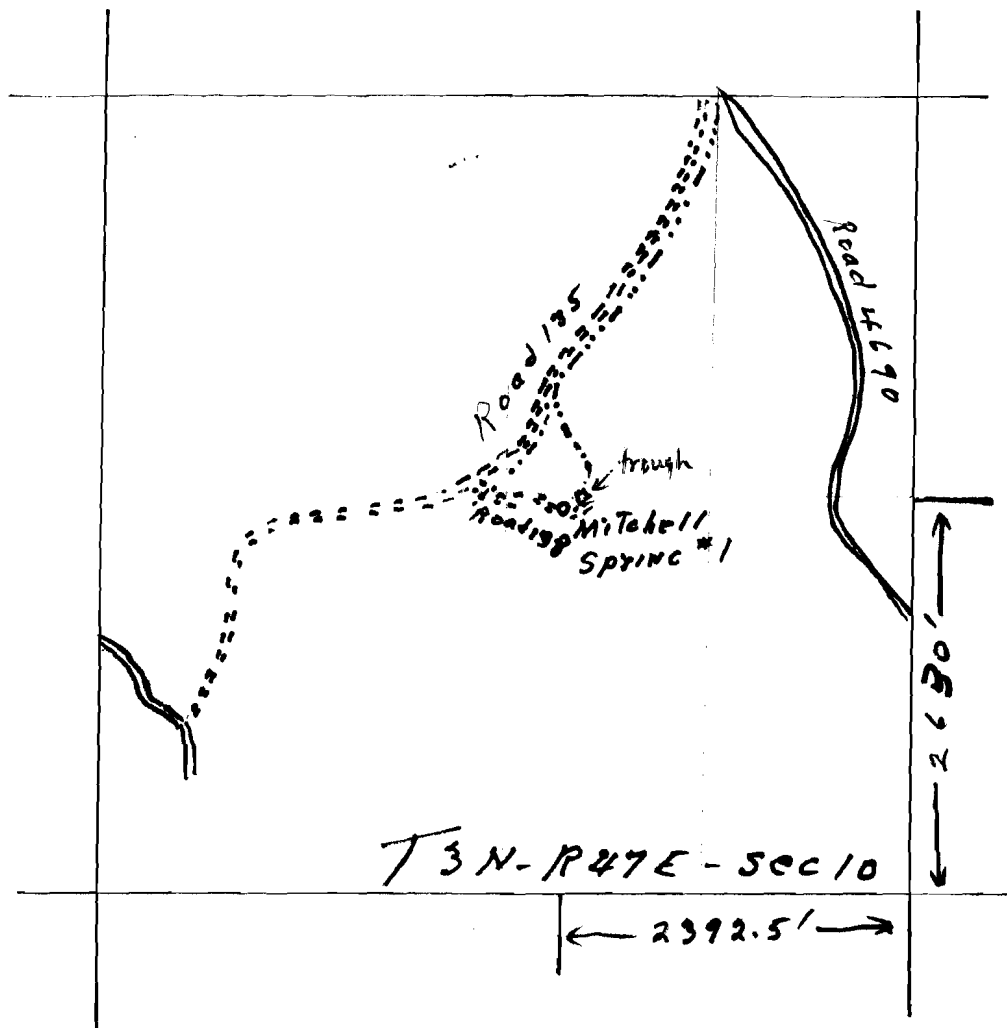

4 INCHES = 1 MILE

NORTH
↑

RECEIVED

AUG 19 1982
WATER RESOURCES DEPT.
SALEM, OREGON