


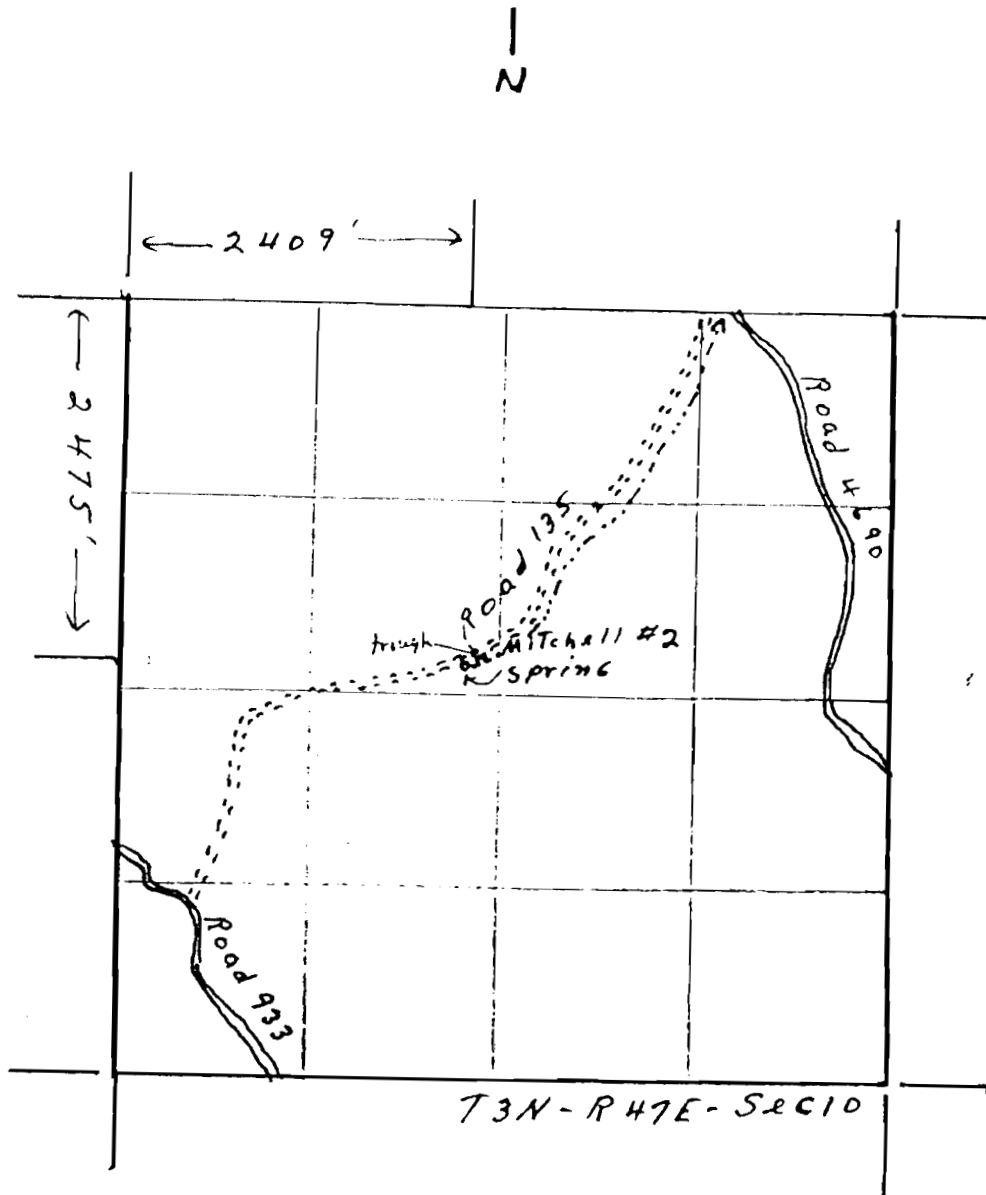

4 Inches = 1 Mile

RECEIVED

AUG 19 1982

WATER RESOURCES DIV
SALEM, OREGON

copy