


N ↑

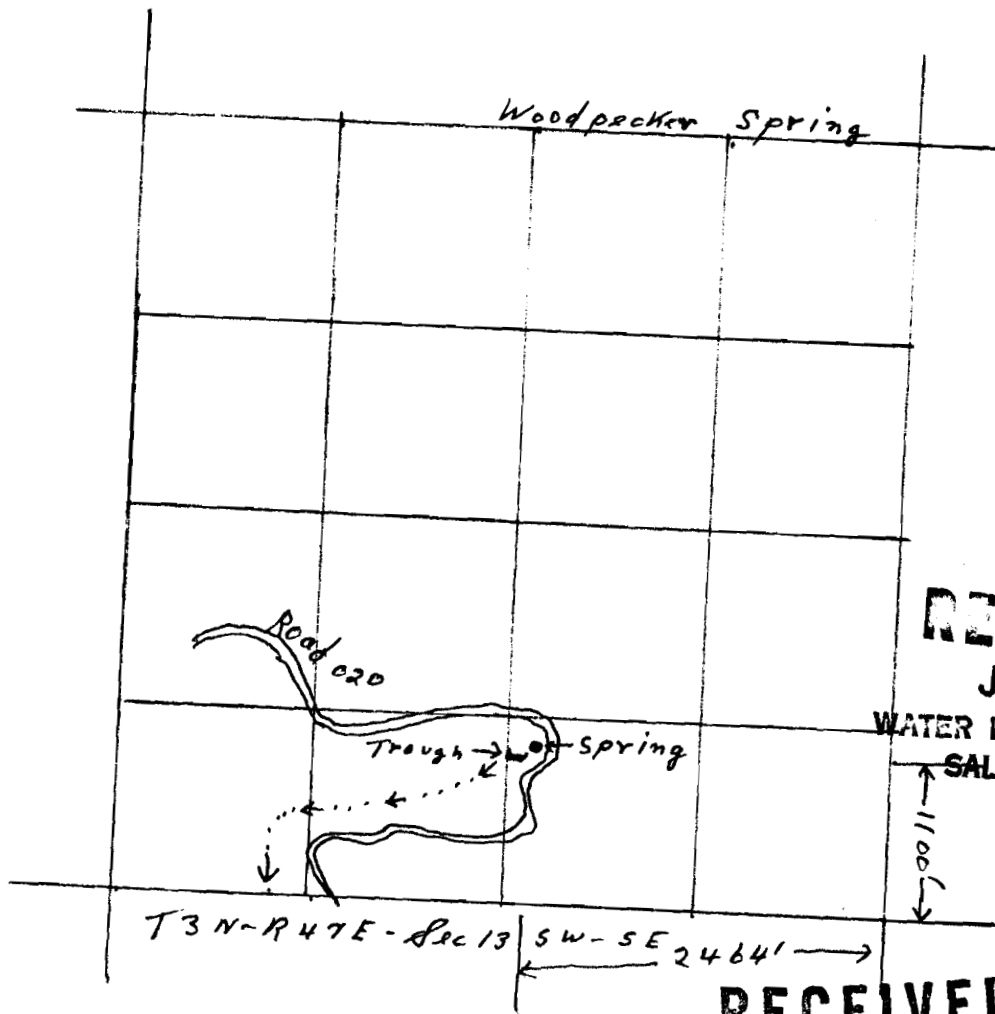

RECEIVED
APR 6 1983
WATER RESOURCES DEPT.
SALEM, OREGON

4 inches = 1 mile

Application No. 63860
Permit No. 48593