


N ↑

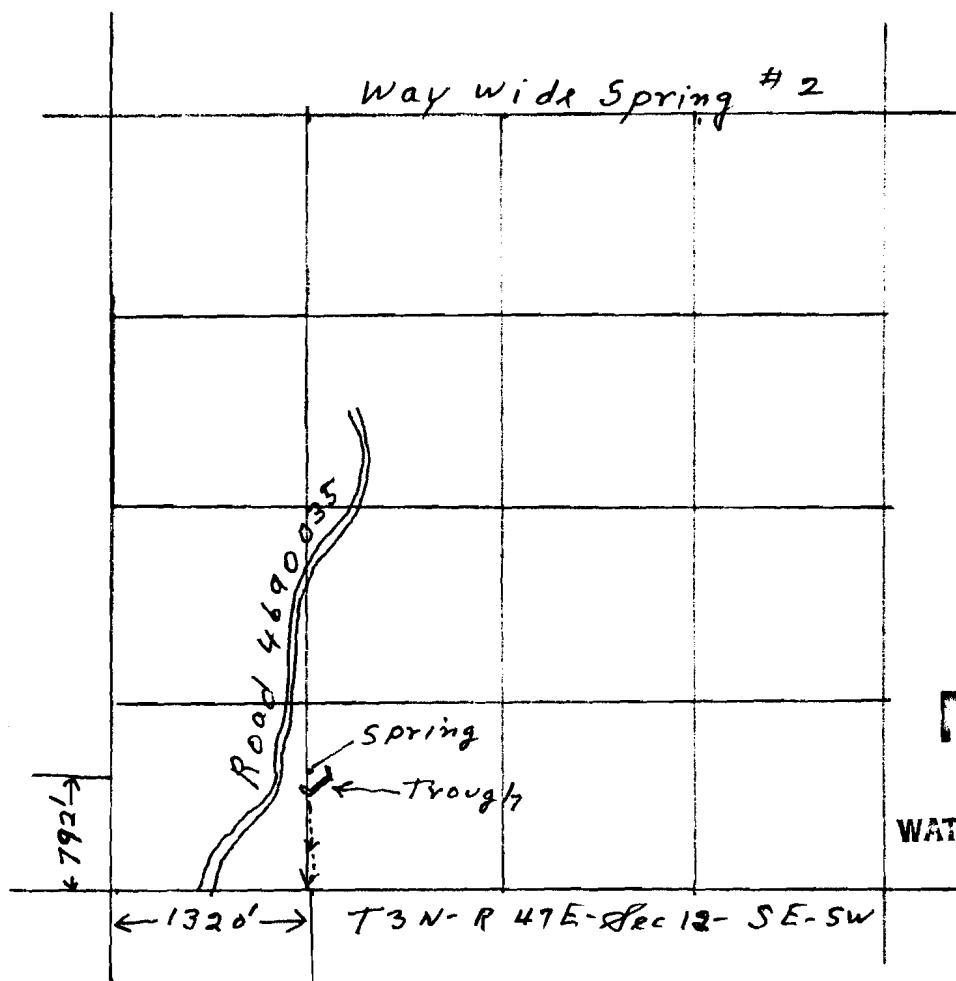

RECEIVED

JUN 10 1983

WATER RESOURCES DEPT.
SALEM, OREGON

RECEIVED

APR 6 1983

WATER RESOURCES DEPT.
SALEM, OREGON

4 inches = 1 mile

Application No. 63862

Permit No. 48595