


Application No. 63863
Permit No. 48596

↑
N

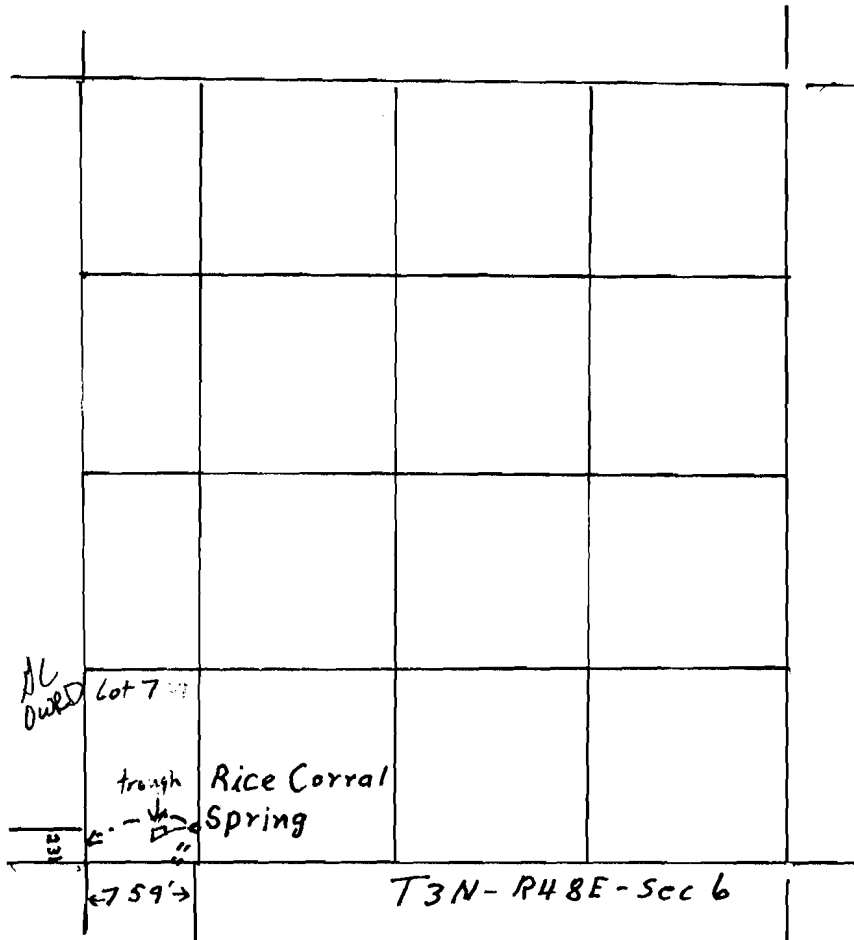

4 Inches = 1 Mile

RECEIVED

AUG 19 1982

WATER RESOURCES DEPT.
SALEM, OREGON