


N ↑

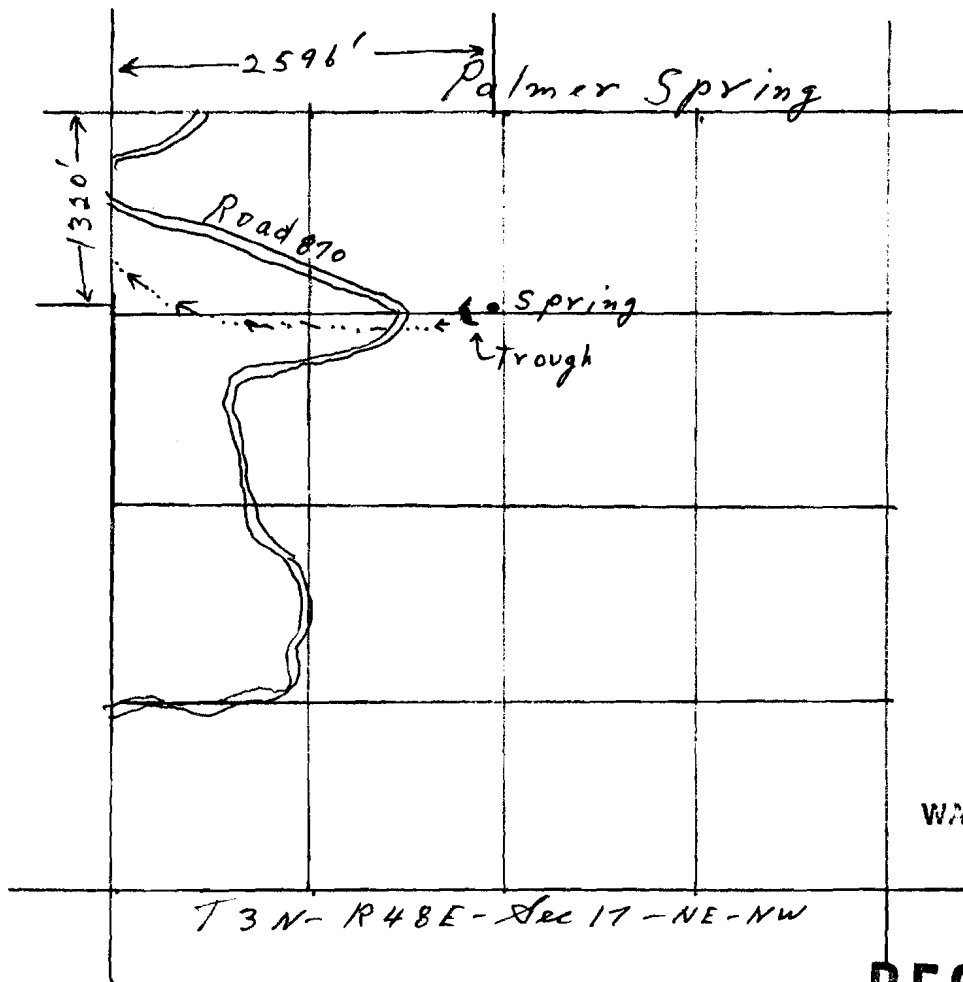

**RECEIVED**

JUN 10 1983

WATER RESOURCES DEPT.  
SALEM, OREGON

**RECEIVED**

APR 6 1983

WATER RESOURCES DEPT.  
SALEM, OREGON

4 inches = 1 mile

Application No. 63864

Permit No. 48597