


Application No. 63867
Permit No. 48600

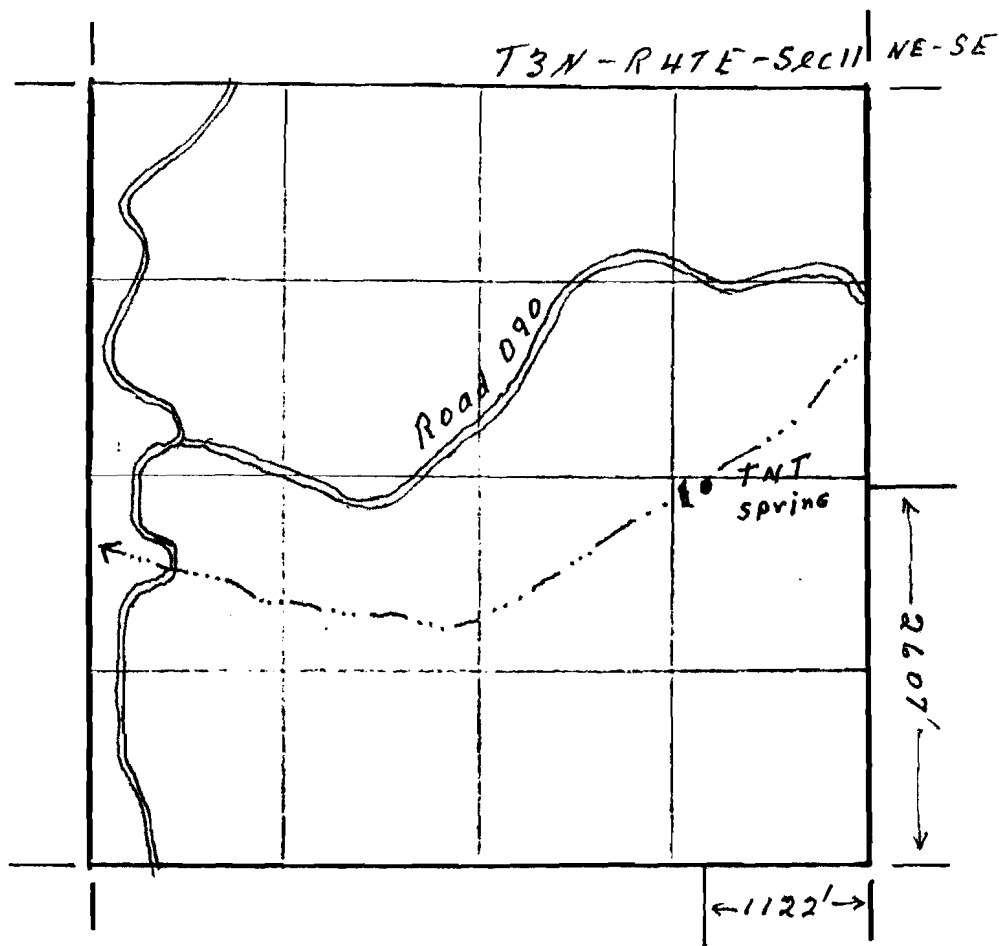

RECEIVED

AUG 19 1982

WATER RESOURCES DEPT.
SALEM, OREGON

4 Inches = 1 Mile

RECEIVED

APR 6 1983

WATER RESOURCES DEPT.
SALEM, OREGON