


Application No. 63871
Permit No. 48604

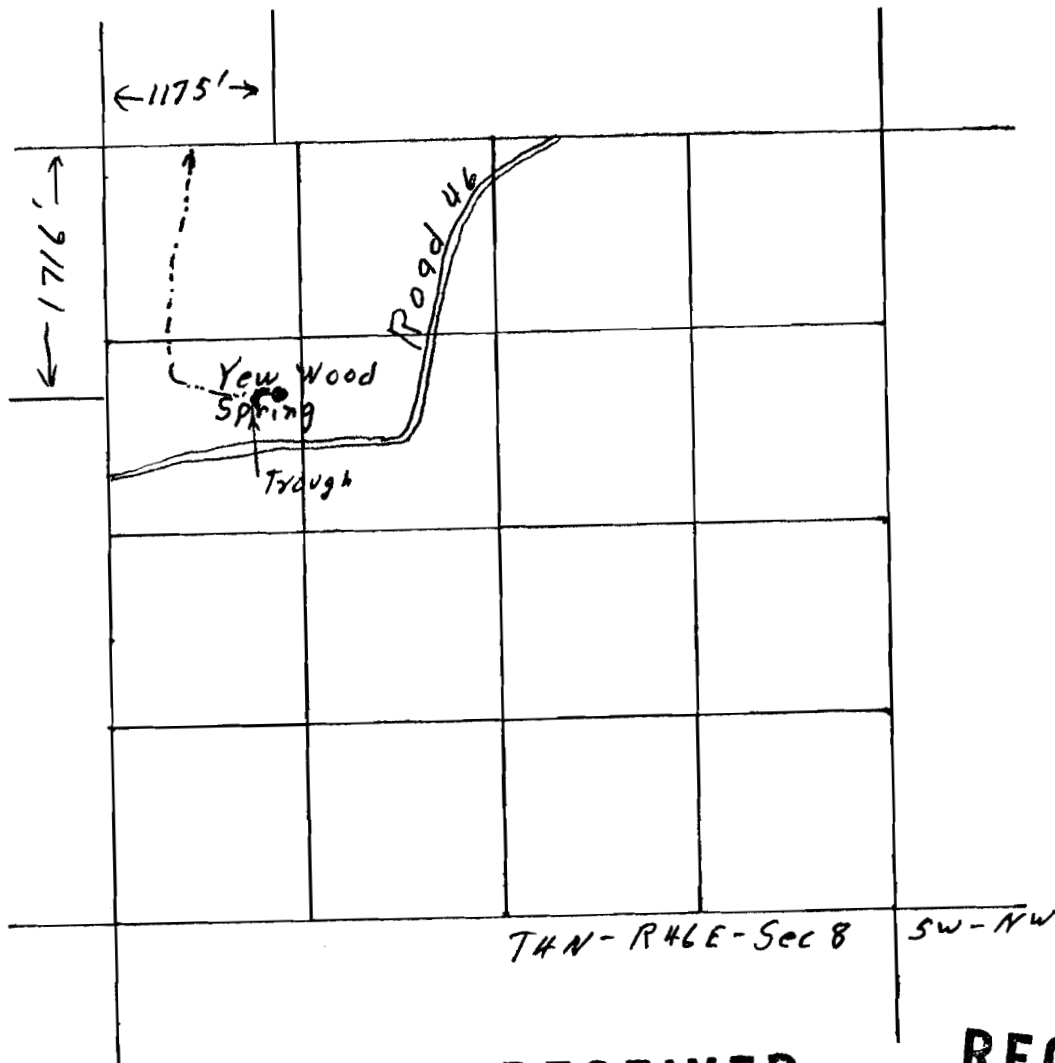

RECEIVED
APR 6 1983
WATER RESOURCES DEPT.
SALEM, OREGON

RECEIVED
AUG 19 1982
WATER RESOURCES DEPT.
SALEM, OREGON

4 inches = 1 mile