


Application No. 63872
Permit No. 48605

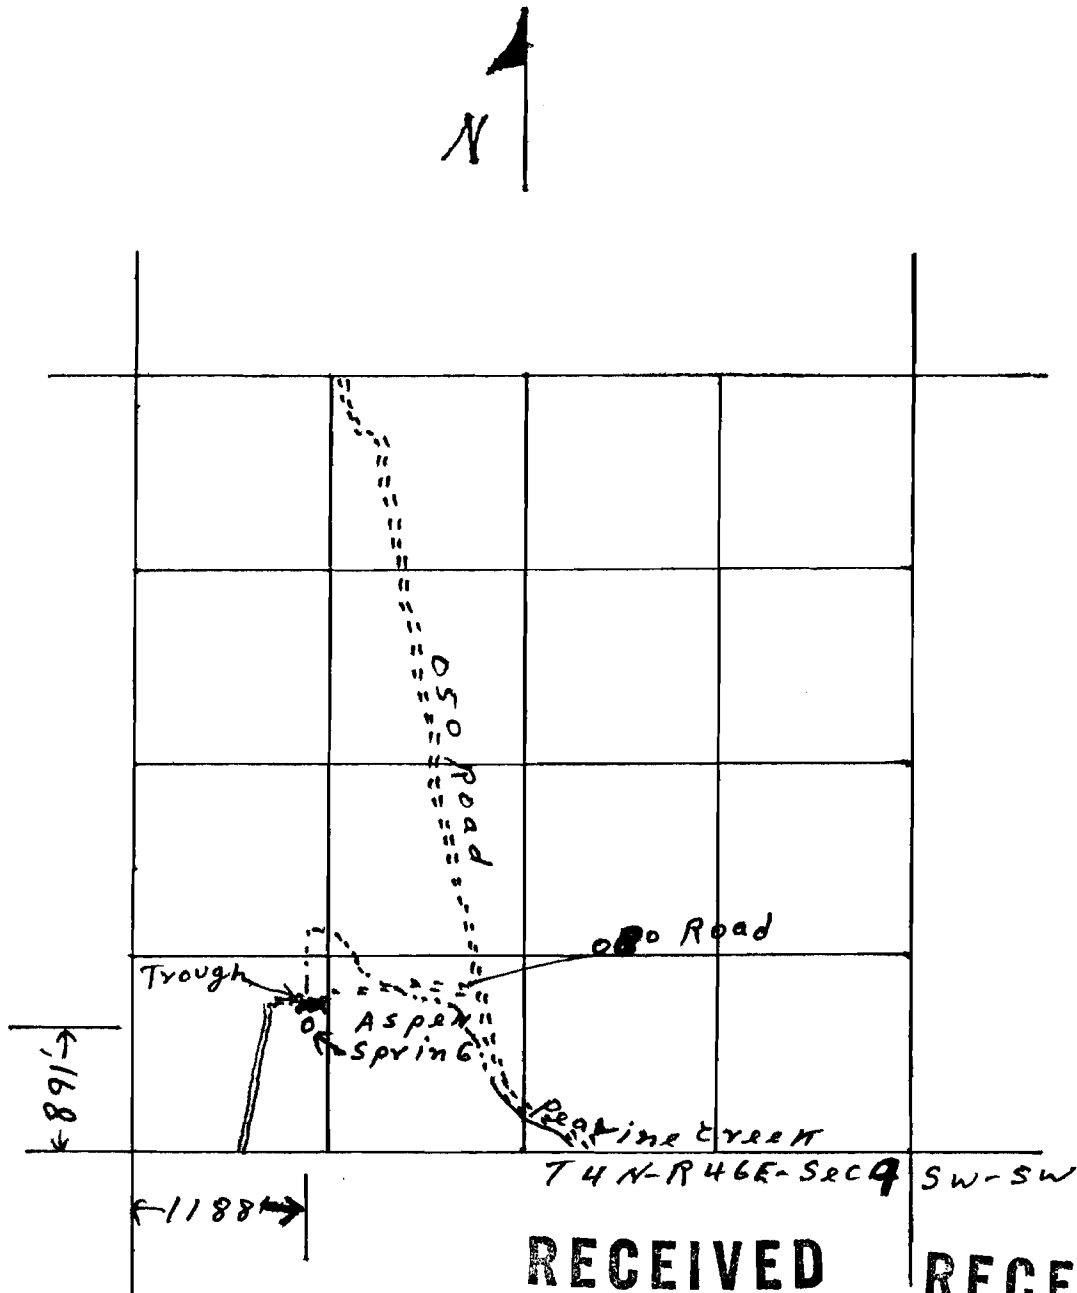

RECEIVED

APR 6 1983

WATER RESOURCES DEPT. WATER RESOURCES DEPT.
SALEM, OREGON SALEM, OREGON

RECEIVED

AUG 19 1982

4 inches = 1 mile