


Application No. 63873
Permit No. 48606

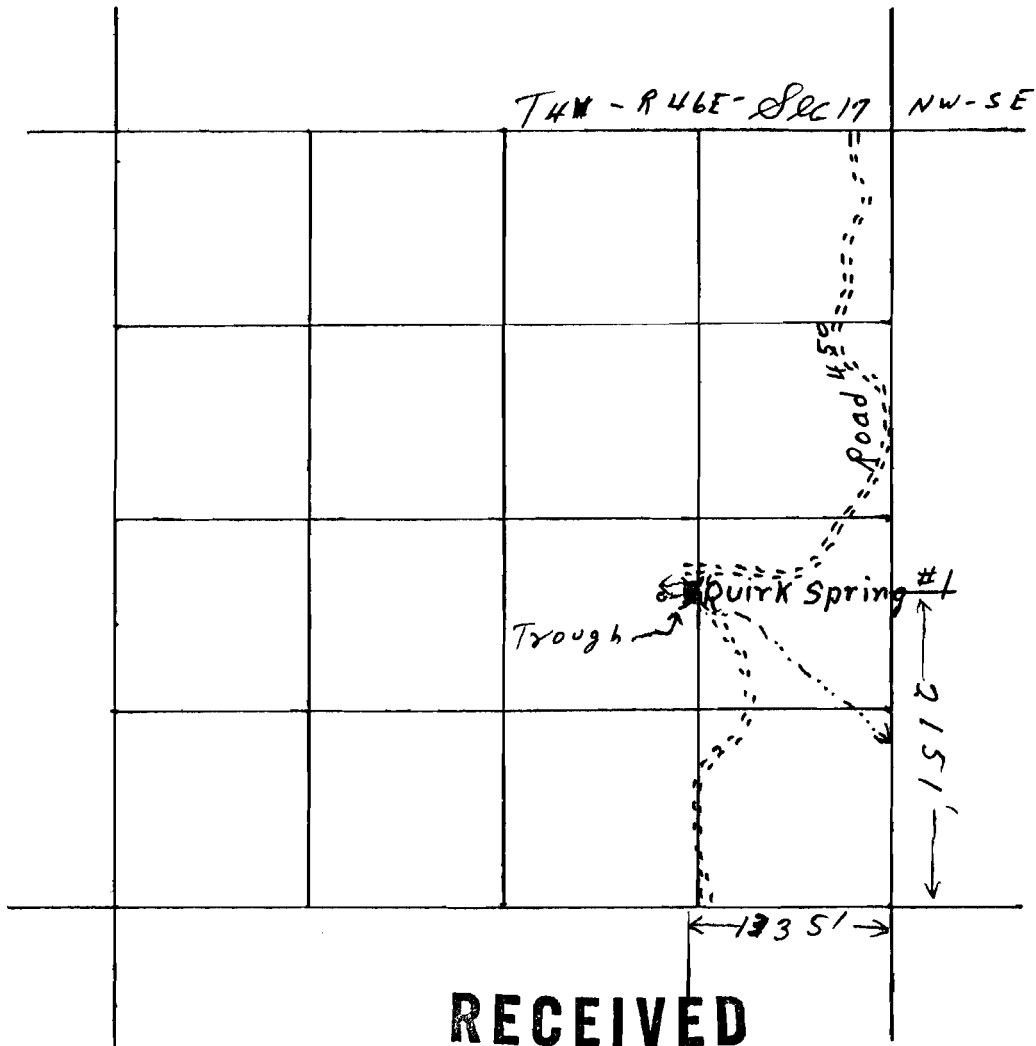

RECEIVED

APR 6 1983
WATER RESOURCES DEPT.
SALEM, OREGON

RECEIVED

AUG 19 1982
WATER RESOURCES DEPT.
SALEM, OREGON

4 inches = 1 mile