


Application No. 638711

Permit No. 48607

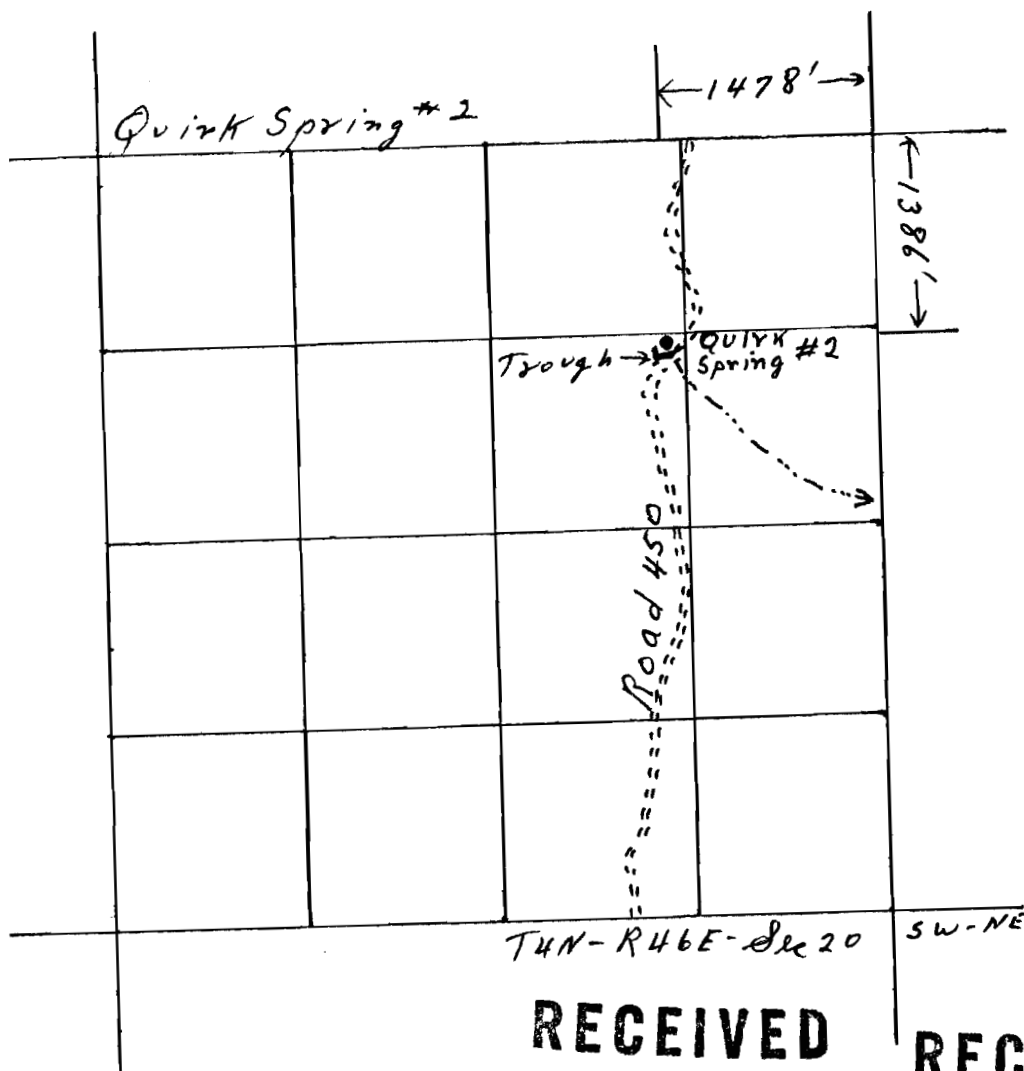

RECEIVED

APR 6 1983

WATER RESOURCES DEPT.
SALEM, OREGON

RECEIVED

AUG 19 1982

WATER RESOURCES DEPT.
SALEM, OREGON

4 inches = 1 mile