


Application No. 63875
Permit No. 48608

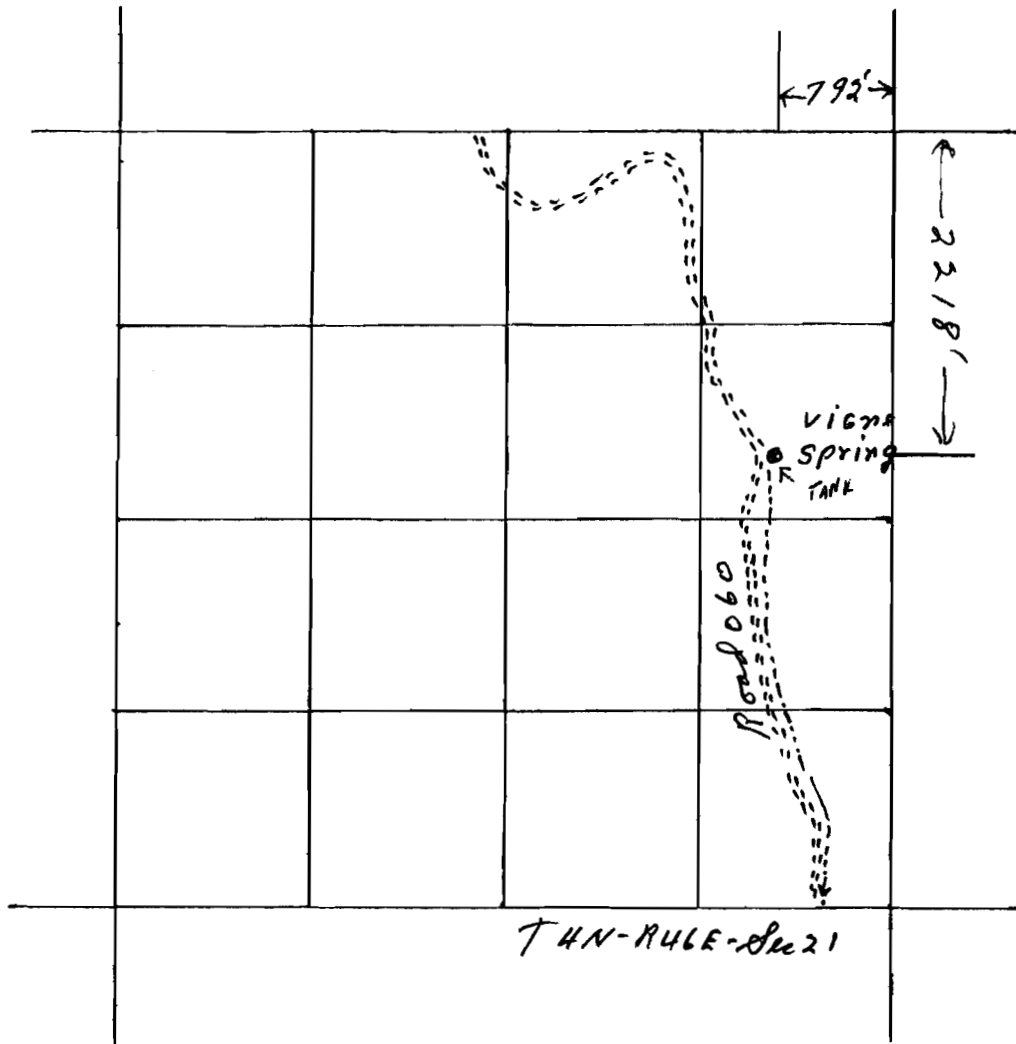

4 inches = 1 mile

RECEIVED

AUG 19 1982

WATER RESOURCES DEPT.
SALEM, OREGON