


Application No. 63881
Permit No. 48613

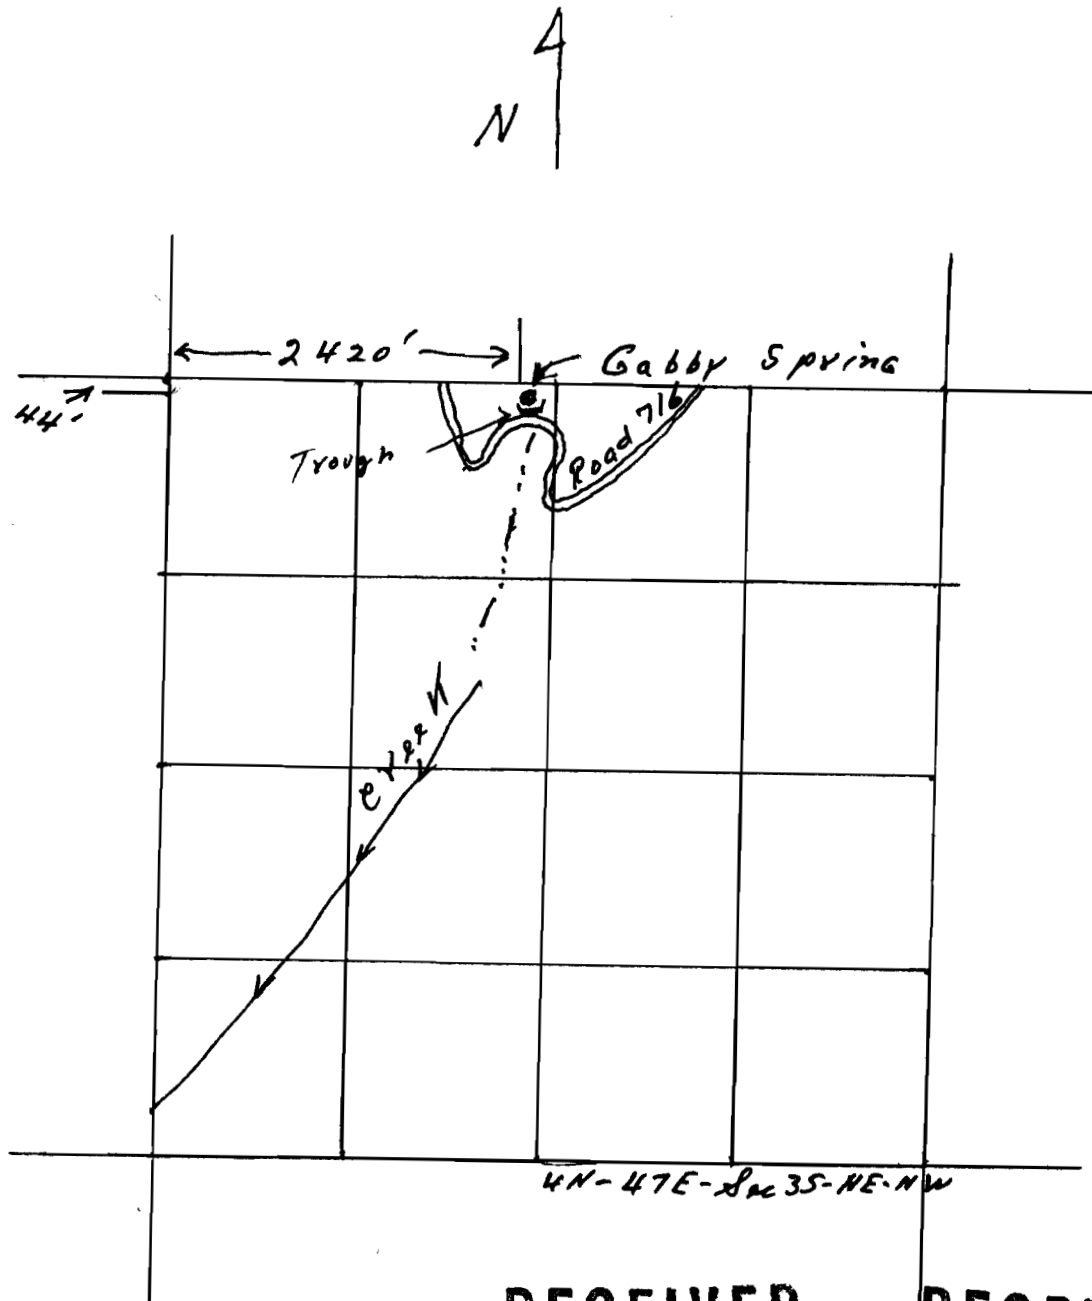

RECEIVED

APR 6 1983

WATER RESOURCES DEPT.
SALEM, OREGON

RECEIVED

AUG 19 1982

WATER RESOURCES DEPT.
SALEM, OREGON

4 inches = 1 mile