


Application No. 63921  
 Permit No. 48693



JUL 21 1983  
 WATER RESOURCES DEPT.  
 SALEM, OREGON

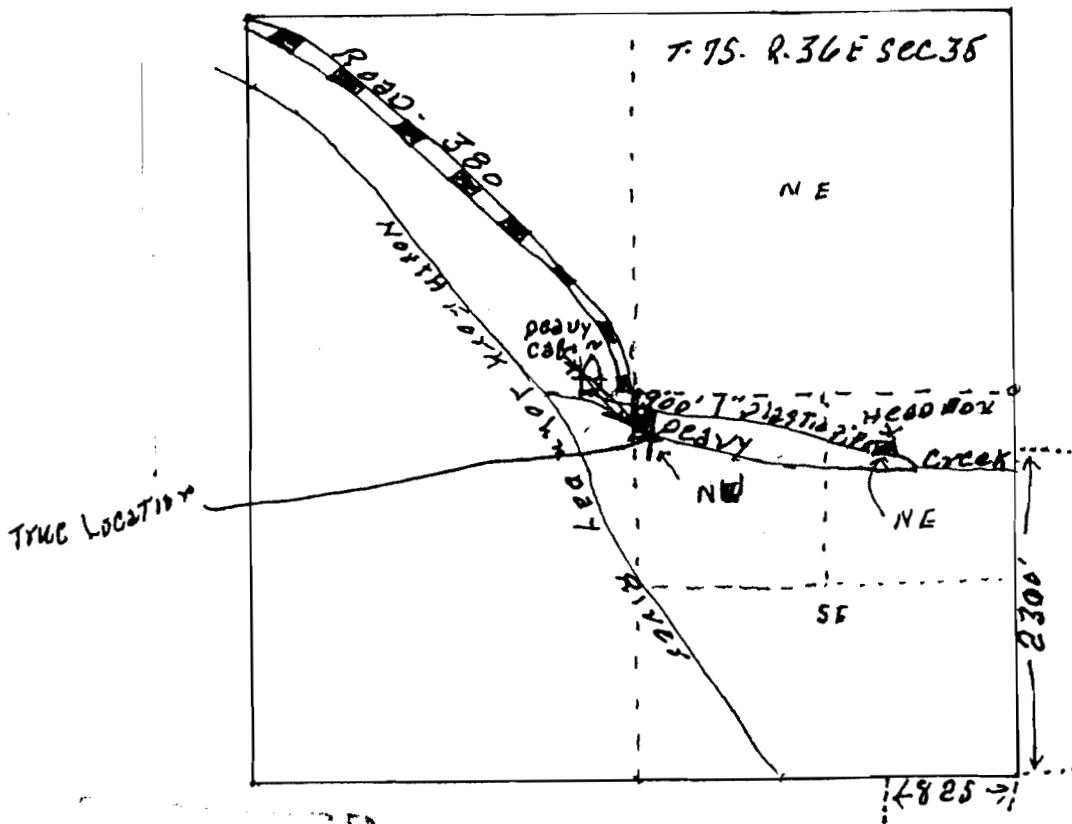

4" = 1 mile

**RECEIVED**

AUG 23 1982  
 WATER RESOURCES DEPT.  
 SALEM, OREGON

**RECEIVED**

APR 29 1983  
 WATER RESOURCES DEPT.  
 SALEM, OREGON

**RECEIVED**

MAR 25 1983  
 WATER RESOURCES DEPT.  
 SALEM, OREGON