


Application No. 63929
Permit No. 48701

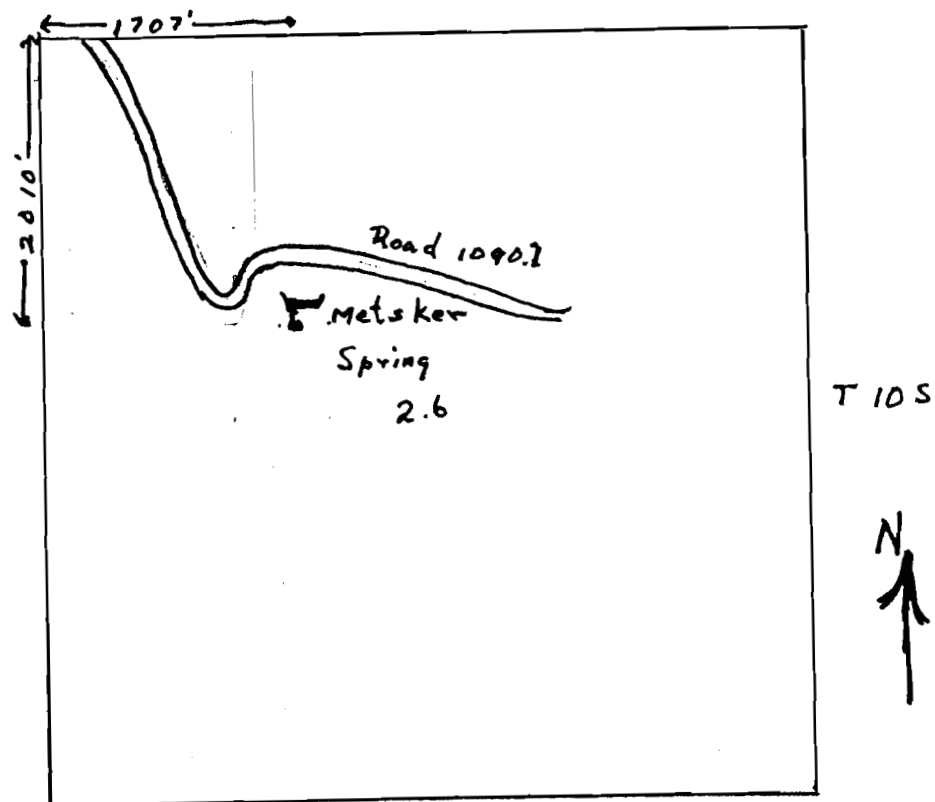

R. 37 E

Sec 26

4" → 1 mile

RECEIVED
APR 29 1983
WATER RESOURCES DEPT.
SALEM, OREGON

63929