


T. 9 S., R. 38 E., W.M.


SECTION 21

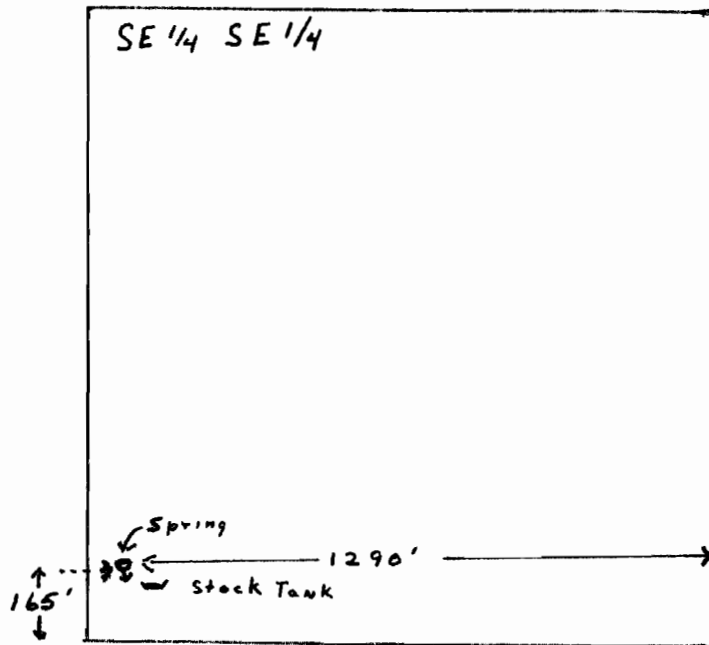

SCALE 1" = 400'

RECEIVED

AUG 25 1983  
WATER RESOURCES DEPT.  
SALEM, OREGON

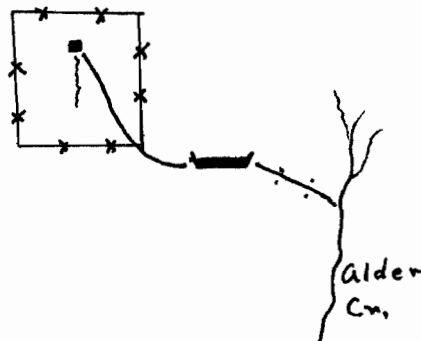

Water Development

- Spring Box
- ✕✕ Protection Fence
- 1 1/2' Pipe
- ÷÷ Overflow Pipe
- Stock Tank

Scale of Water Development  
1" = 100ft.

Application No. 64488

Permit No. 48709

APPLICATION # 32

DEPARTMENT OF AGRICULTURE  
FOREST SERVICE  
FIELD MAP SHEET

Scale ..... inches = 1 mile.

T. 9S R. 38E Sec. 21

Unit .....

Mag. Dec. .... Acres .....


(Case designation)

Application No. 6-488  
Permit No. 48709

RECEIVED

OCT 20 1982

WATER RESOURCES DEPT.  
SALEM, OREGON.

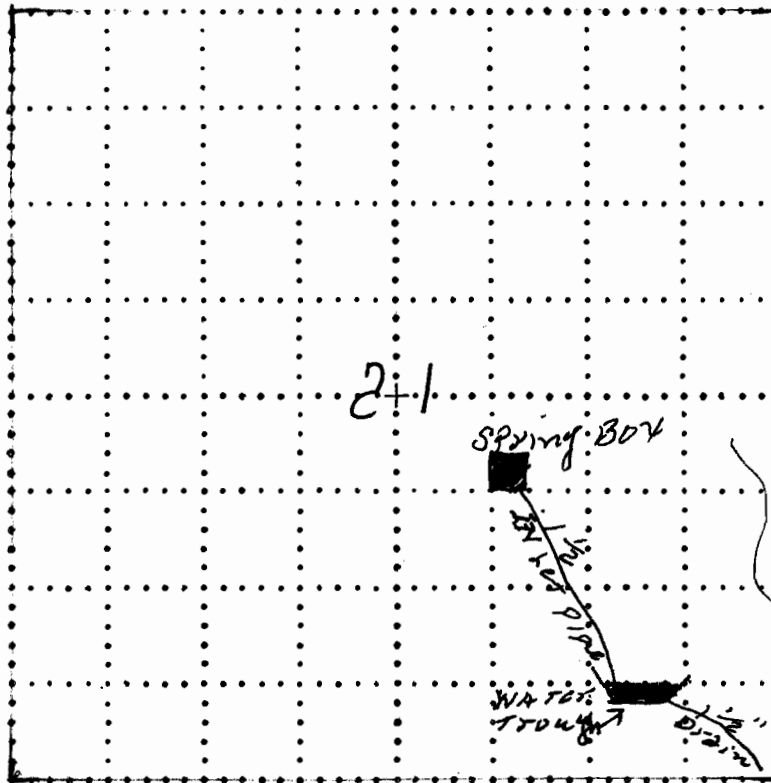

NOT TO SCALE

RECEIVED

AUG 25 1983

WATER RESOURCES DEPT.  
SALEM, OREGON

Field work by ..... Date ..... Platted by .....

Remarks .....

Approved ..... 19.....

90-19 (10/59)

GPO 889999

Approving Officer.

Application # 32

DEPARTMENT OF AGRICULTURE  
FOREST SERVICE  
FIELD MAP SHEET

Scale ..... inches = 1 mile.

T. .... R. .... Sec. ....

Mag. Dec. .... Acres .....

Unit .....  
(Case designation)

Application No. 64488  
Permit No. 48709

T-9S R-38E Sec 21

2+1



4" mile

RECEIVED

AUG 25 1983

WATER RESOURCES DEPT.  
SALEM, OREGON

RECEIVED

OCT 20 1982

WATER RESOURCES DEPT.  
SALEM, OREGON

RECEIVED

SEP 23 1982

WATER RESOURCES DEPT.  
SALEM, OREGON

Field work by ..... Date ..... Platted by .....

Remarks .....

Approved ..... 19.....