


RECEIVED

JAN - 4 1988


WATER RESOURCES DEPT.
SALEM, OREGON

T. 11 S., R. 41 E., W.M.

SECTION 30

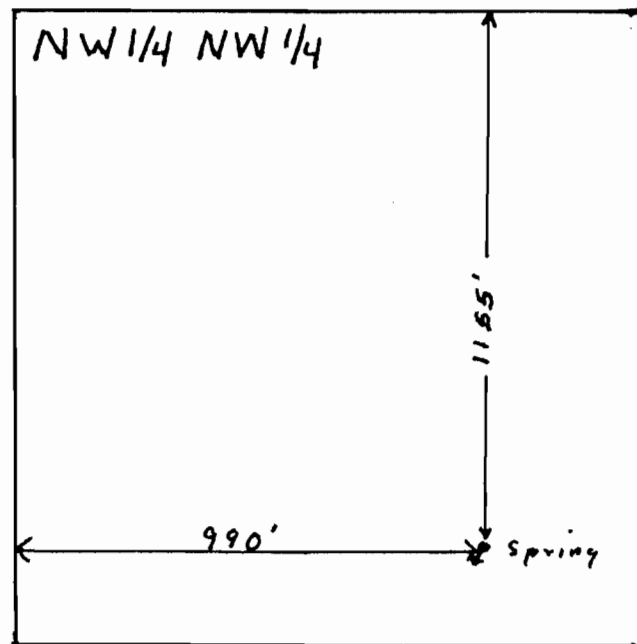

SCALE 1" = 400'

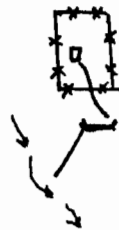

Water Development
E. Dark Cy. Springs

- Spring Box
- xx Protection Fence
- Stock Tank
- Transport Pipe
- Drain
- ~ Drainage

Scale

1 in. = 100 ft.

Application No. 64497
Permit No. 48717

RECEIVED

AUG 25 1983

WATER RESOURCES DEPT.
SALEM, OREGON