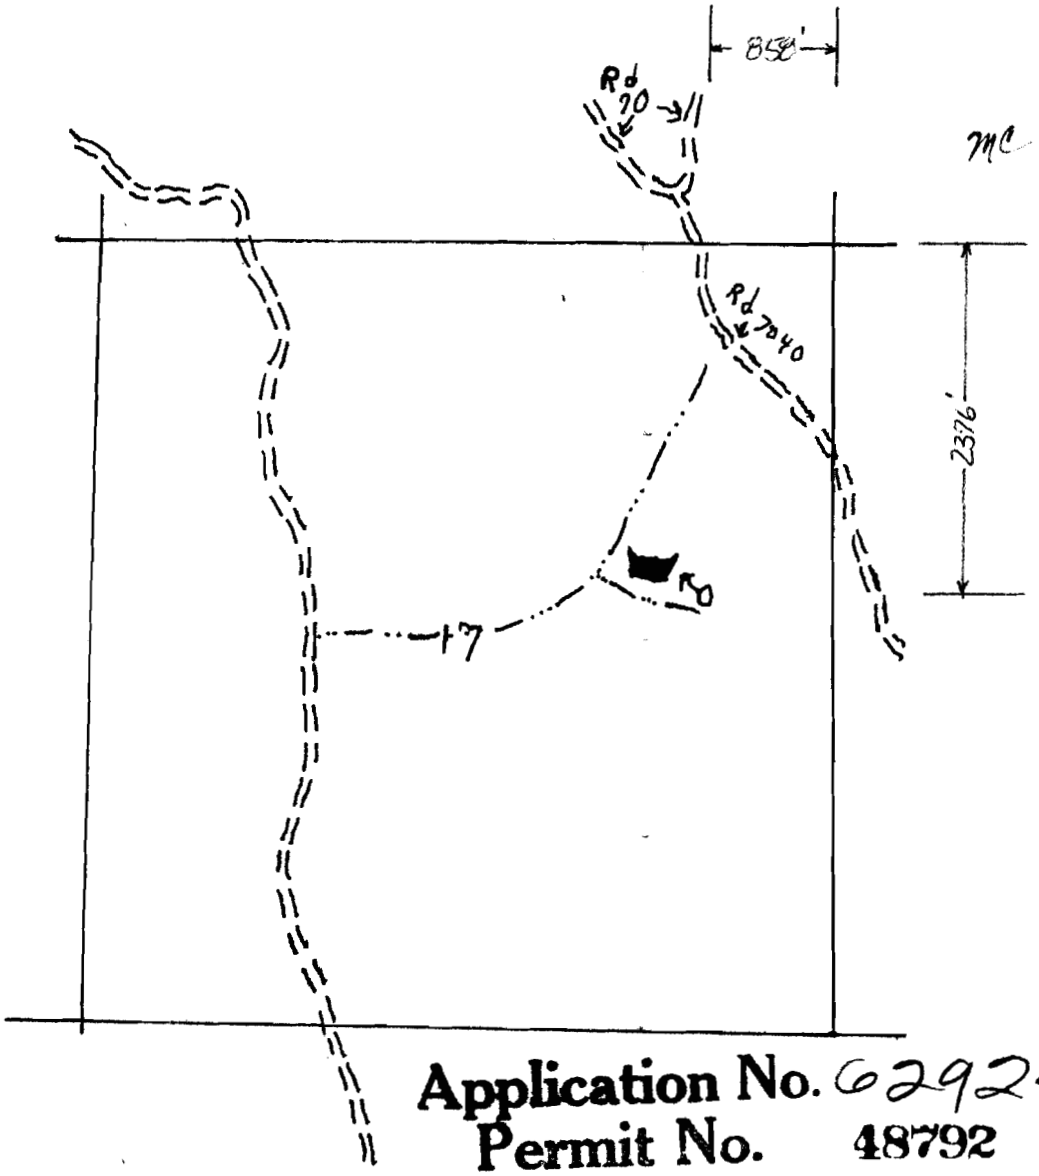


Application No. 62924
Permit No. 48792

Payton Spring

SE¼NE¼ Sec.17, T7S., R[illegible]E.

Water Trough

Spring Head

Drainage

Road

RECEIVED
MAR 16 1983
WATER RESOURCES DEPT.
SALEM, OREGON

Four Inches = One Mile

0 1 2 3 4 in

RECEIVED
OCT 21 1981
WATER RESOURCES DEPT
SALEM, OREGON