


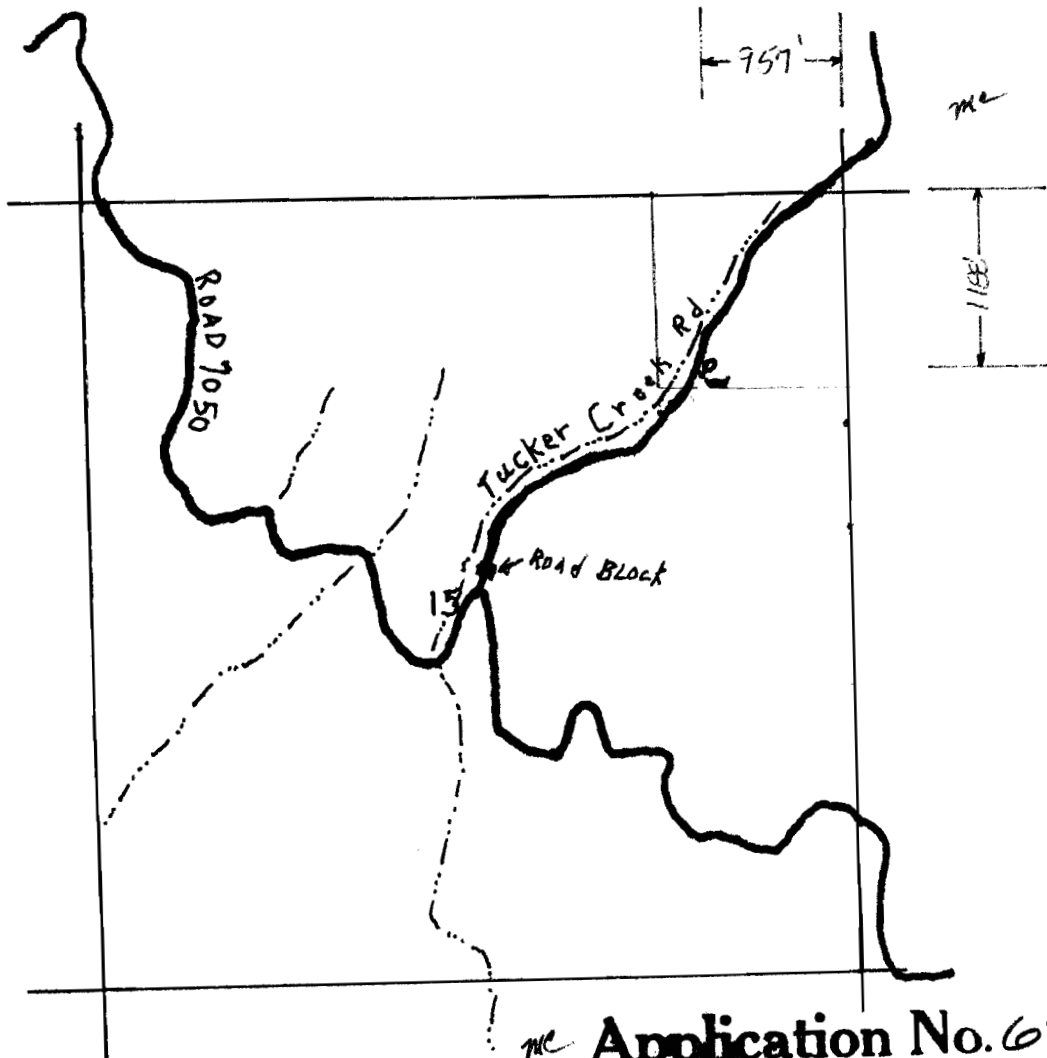

TUCKER CR. SPRING #1
G.T. Spring

NE 1/4
SW 1/4 NE 1/4 Sec. 15, T7S, R. 42E.

Application No. 62925
Permit No. 48793

Water Trough

Spring Head

Road

Drainage

Four Inches = One Mile



RECEIVED

MAY 11 1983

WATER RESOURCES DEPT.
SALEM, OREGON

RECEIVED

MAR 16 1983

WATER RESOURCES DEPT.
SALEM, OREGON

RECEIVED

OCT 2 1981

WATER RESOURCES DEPT.
SALEM, OREGON