


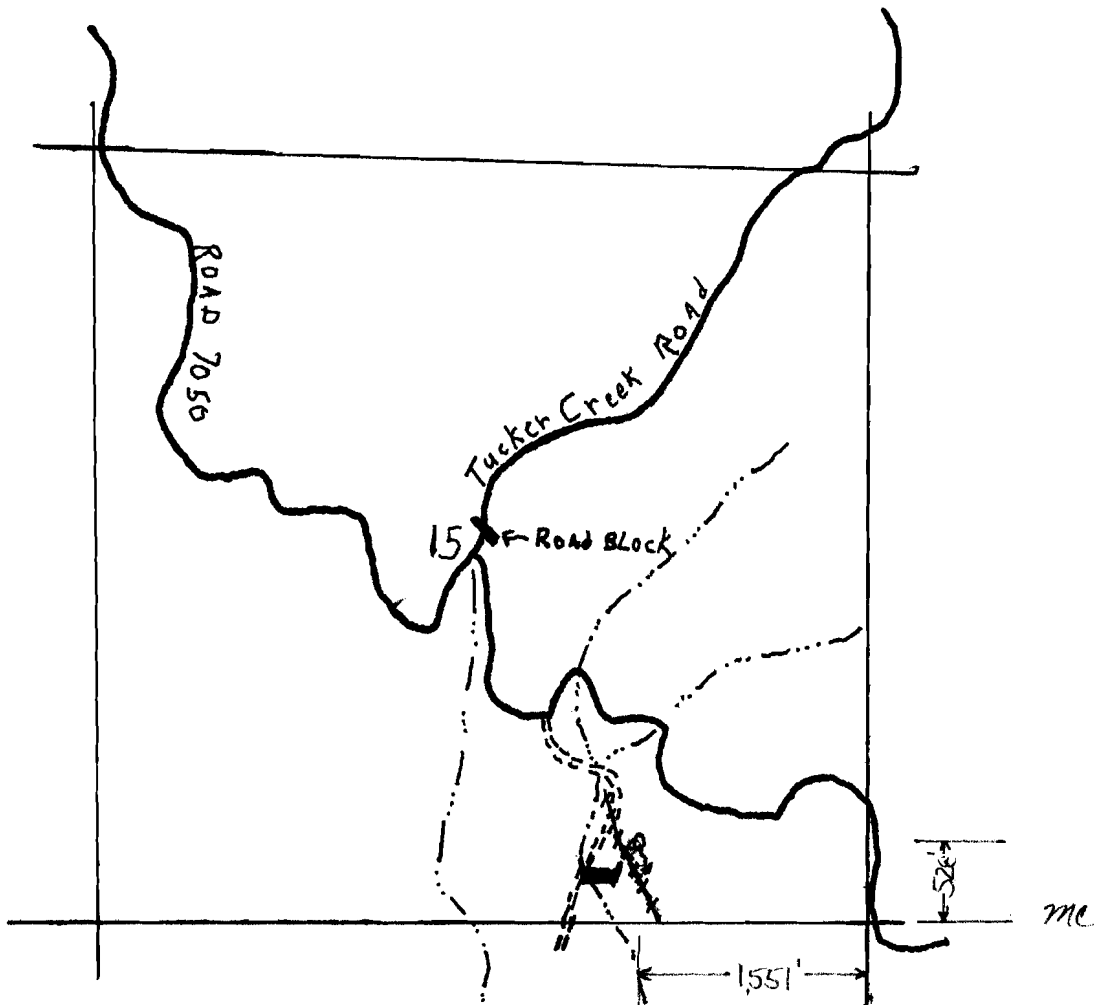

Application No. 62926
 Permit No. 48794

Morrissey Spring

OK SW $\frac{1}{4}$ SE $\frac{1}{4}$ Sec 15, T. 7S R. 42E

Water Trough

Spring Head

Main Road

Spur Road

Drainage

Fence

RECEIVED

MAR 16 1983

WATER RESOURCES DEPT.
 SALEM, OREGON

RECEIVED

OCT 2 1981

WATER RESOURCES DEPT.
 SALEM, OREGON

Four Inches = One Mile

