


WATER RESOURCES DEPT
SALEM, OREGON

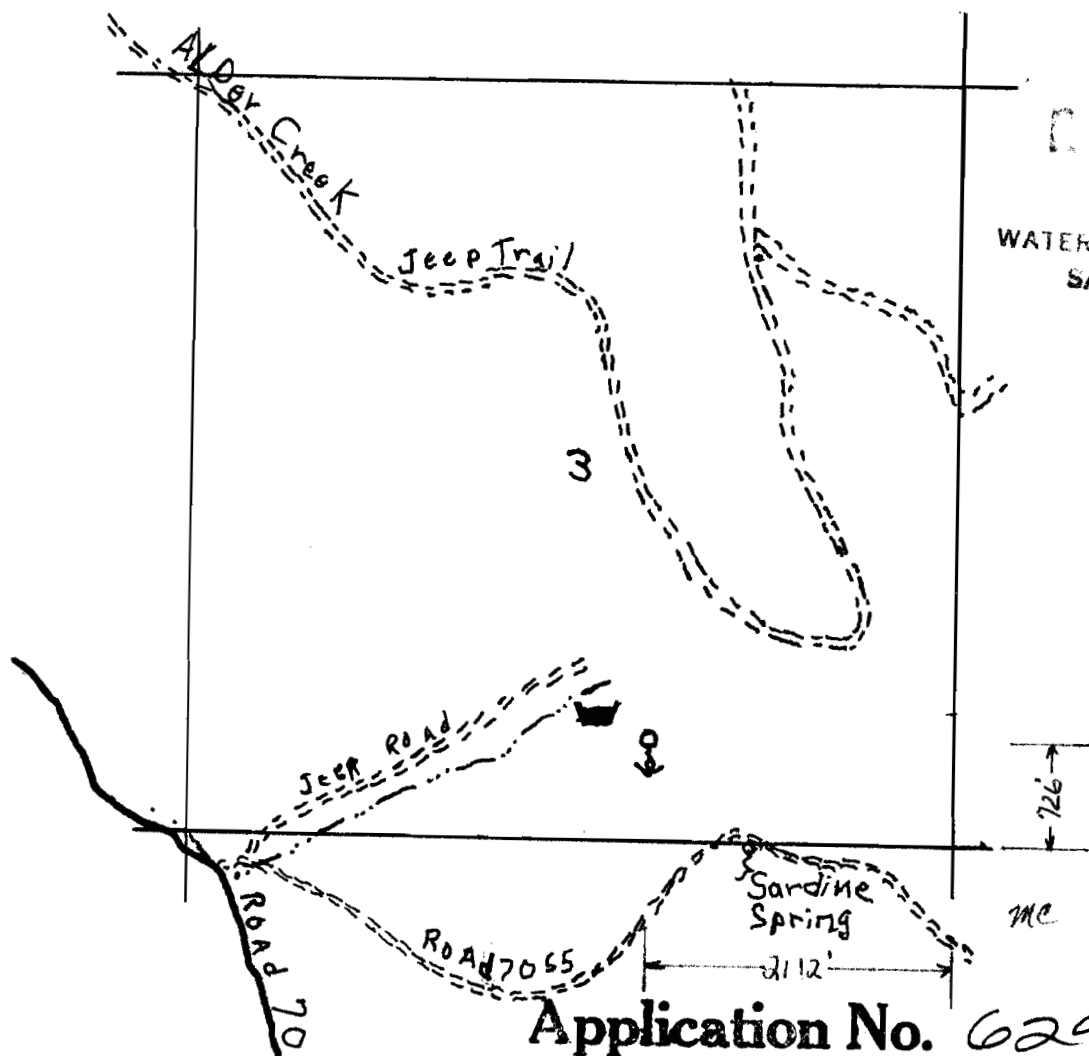

Application No. 62927
Permit No. 48795

Wanker Spring

SW¹/₄ SE¹/₄ Sec. 3 T7S, R. 42E.

Water Trough

Spring Head

Main Road

Jeep Trail

RECEIVED

MAR 16 1983

WATER RESOURCES DEPT.
SALEM, OREGON

Four Inches = One Mile

