


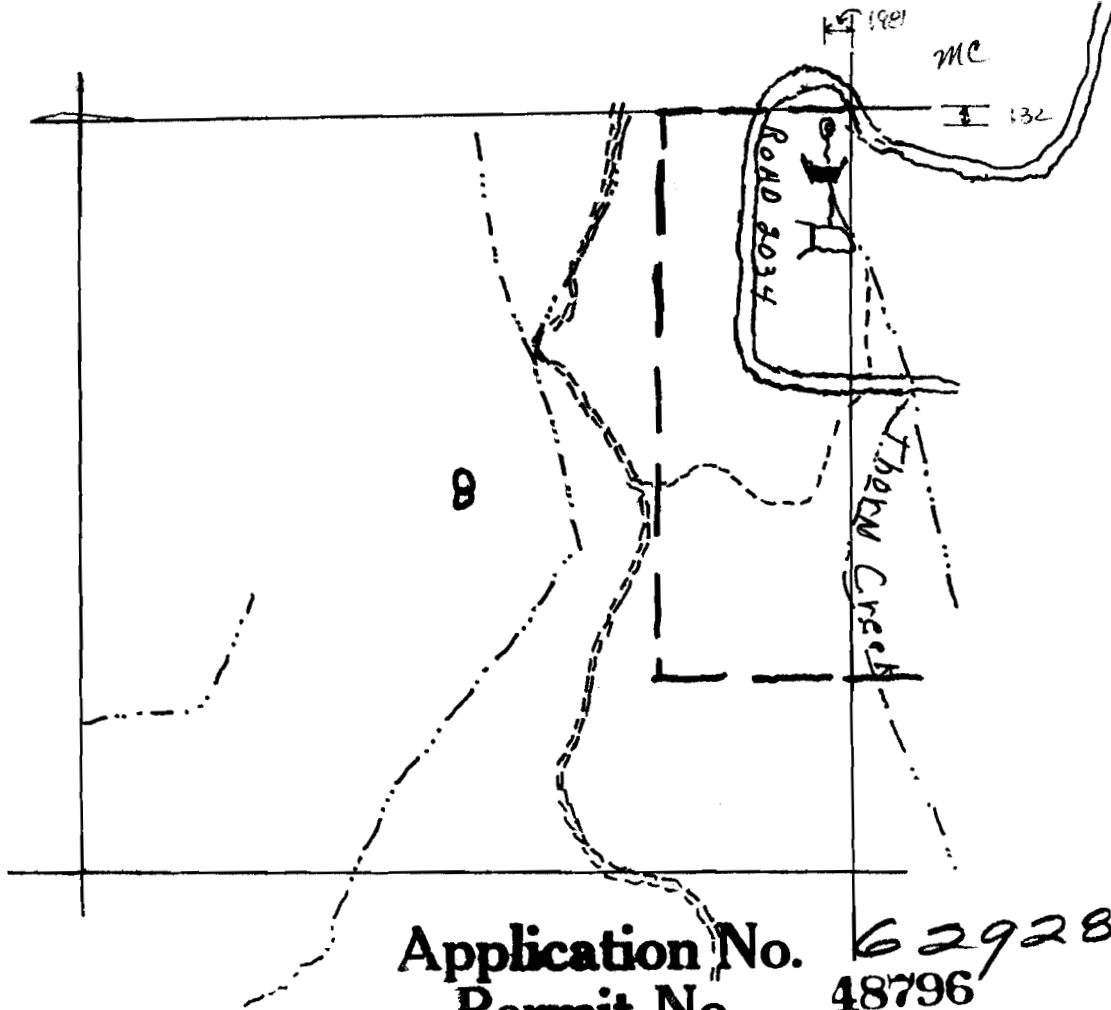

Thorn Spring

NE $\frac{1}{4}$ NE $\frac{1}{4}$ Sec 8, T6S, R41E


Water Trough



Spring Head




Main Road

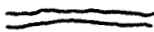

Spur Road




Trail

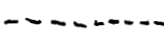


Pond



Drainage

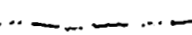

Four Inches = One Mile

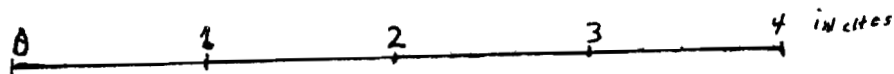

RECEIVED

OCT 2 1981

WATER RESOURCES DEPT.
SALEM, OREGON

RECEIVED

MAR 16 1983

WATER RESOURCES DEPT.
SALEM, OREGON