


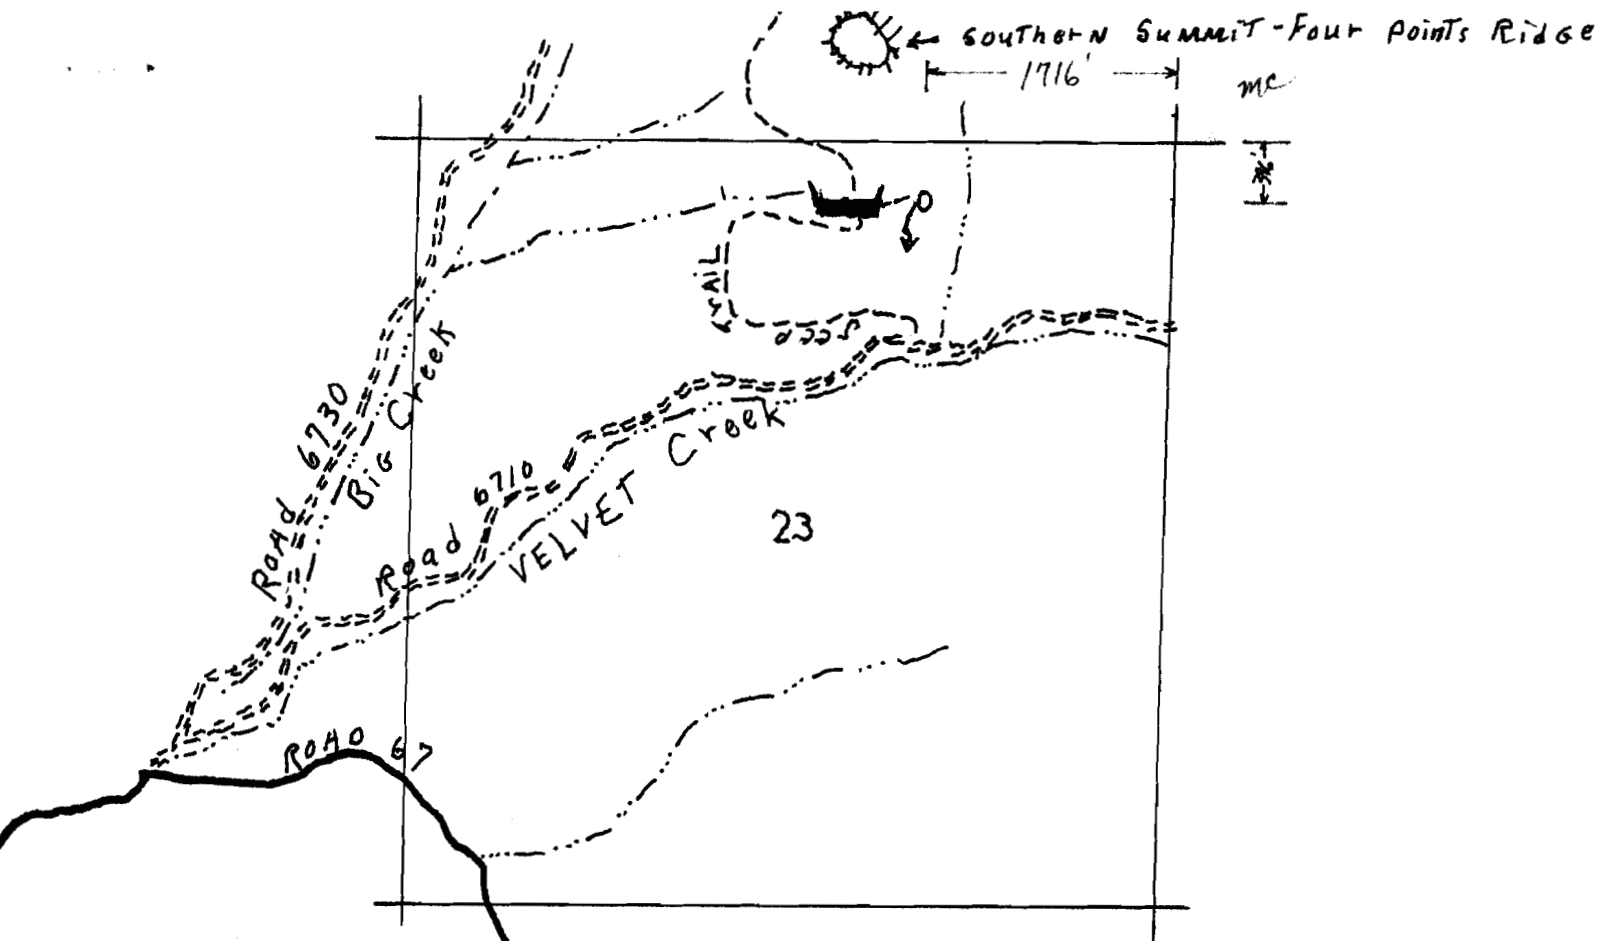

Application No. 62929
Permit No. 48797

Four-Points Spring

NW $\frac{1}{4}$ NE $\frac{1}{4}$ Sec 23, T6S, R42E

Water Trough

Spring Head

Main Road

Secondary Road

Jeep Road

Drainage

Four Inches = One Mile



RECEIVED

OCT 2 1981

WATER RESOURCES DEPT.
SALEM, OREGON

RECEIVED

MAR 16 1983

WATER RESOURCES DEPT.
SALEM, OREGON