


WHISKEY SPRING

Application No. 62930
Permit No. 48798

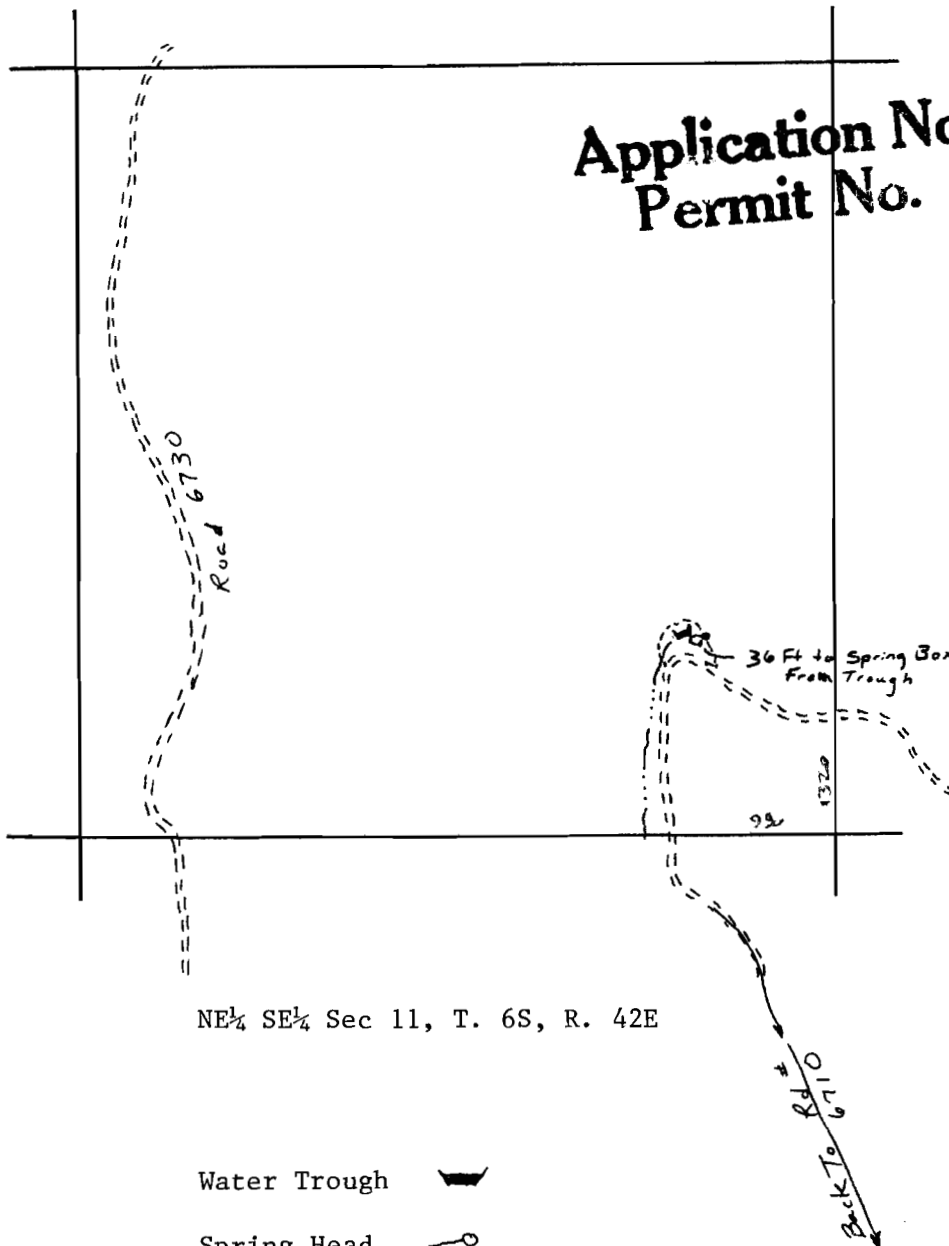

NE $\frac{1}{4}$ SE $\frac{1}{4}$ Sec 11, T. 6S, R. 42E

Water Trough

Spring Head

Main Road

Spur Road

Drainage

Four Inches = One Mile

0 1 in. 2 in. 3 in. 4 in.

RECEIVED

OCT 2 1981

WATER RESOURCES DEPT
SALEM, OREGON