

TOIN SPRING


LOST SPRING

Application No. 62931
Permit No. 48799

RECEIVED

OCT 2 1981

WATER RESOURCES DEPT
SALEM, OREGON

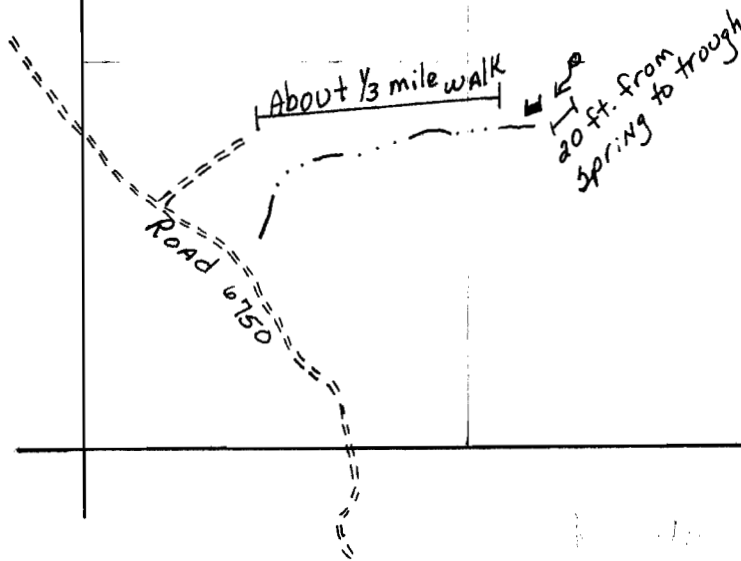

NW $\frac{1}{4}$ SE $\frac{1}{4}$ Sec. 9, T.6S., R.42E.

Water Trough



Spring Head



Drainage



Road



RECEIVED

MAR 16 1983

WATER RESOURCES DEPT.
SALEM, OREGON

Four Inches = One Mile

