


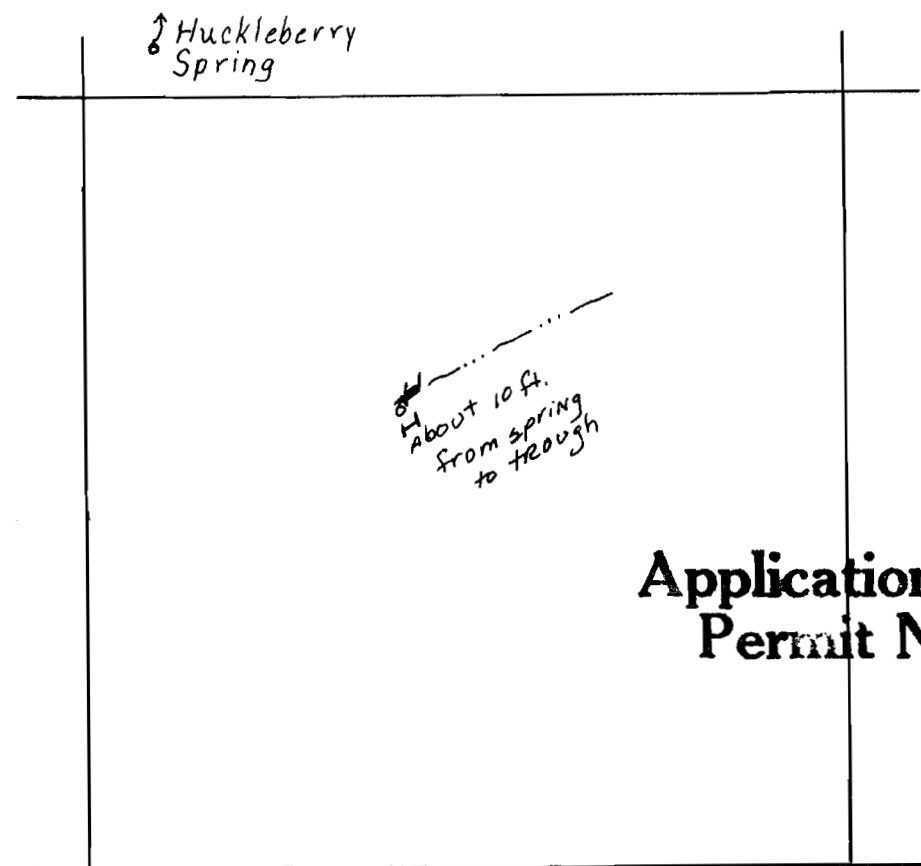

RECEIVED

OCT 2 1981

WATER RESOURCES DEPT
SALEM, OREGON

Application No. 62932
Permit No. 48800

WEST PRONG SPRING

SE $\frac{1}{4}$ NW $\frac{1}{4}$ Sec.33, T.5S., R.42E.

Water Trough



Spring Head



Drainage



Four Inches = One Mile

