

UNITED STATES DEPARTMENT OF AGRICULTURE
FOREST SERVICE

6917

MAP SHEET


No. _____ Mount Hood National Forest.

Division _____ District _____, Block _____

T. 2 S., R. 10 E. W. M., Section 2, Quarter SW

Mapped by S. C. Walters Scale: 2 inches = 1 mile.

1031
28

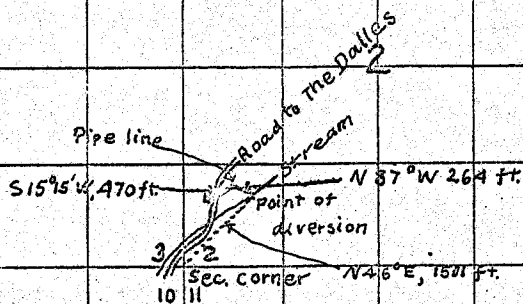

I, S. C. Walters, of Mt. Hood, Oregon, do hereby certify that this map was made from notes taken during an actual survey made by me on May 5, 1925 and that it correctly represents the works described in the application, together with the location of streams and other ditches in the immediate vicinity.

S. C. Walters
Fire Ranger (Surveyor)

10318
6917