


BUCKHORN SPRING

Application No. 62933
Permit No. 48801

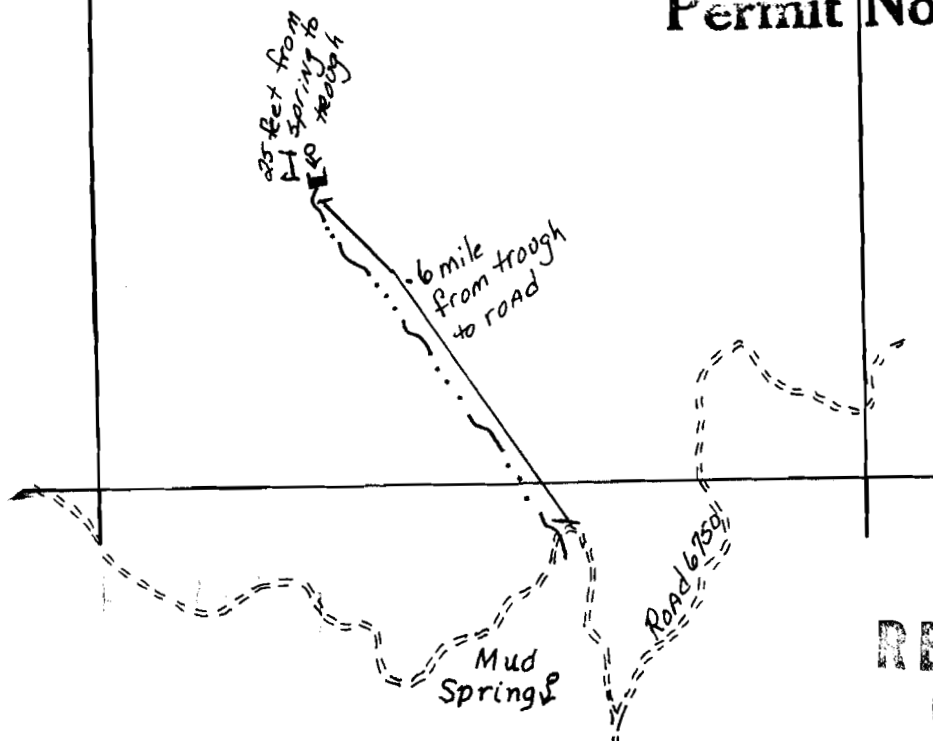

NE 1/4 SW 1/4 Sec. 5, T.6S., R.42E.


Water Trough



Spring Head




Road

 

Drainage



Four Inches = One Mile

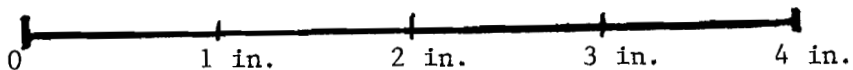

RECEIVED

MAR 16 1983

WATER RESOURCES DEPT.
SALEM, OREGON


RECEIVED

OCT 2 1981

WATER RESOURCES DEPT.
SALEM, OREGON

BUCKHORN SPRING

Application No. 62933
Permit No. 48801

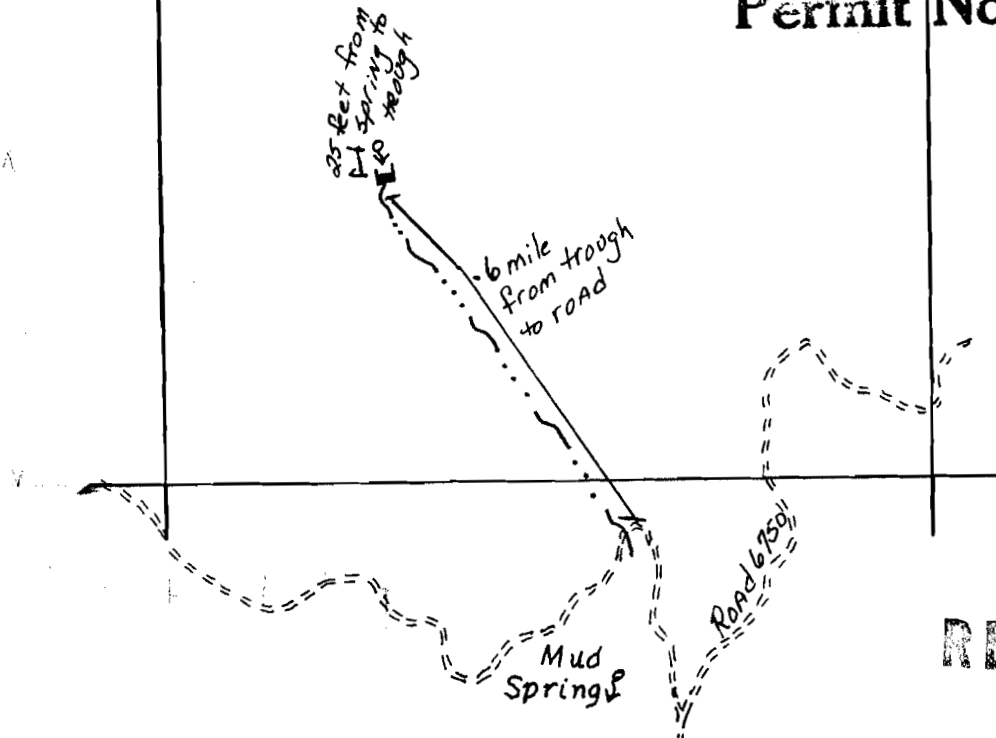

NE $\frac{1}{4}$ SW $\frac{1}{4}$ Sec. 5, T.6S., R.42E.


Water Trough



Spring Head



Road

 

Drainage



RECEIVED

MAR 16 1983

WATER RESOURCES DEPT.
SALEM, OREGON

RECEIVED

OCT 2 1981

WATER RESOURCES DEPT
SALEM, OREGON

Four Inches = One Mile

