


Application No. 64138
Permit No. 48802

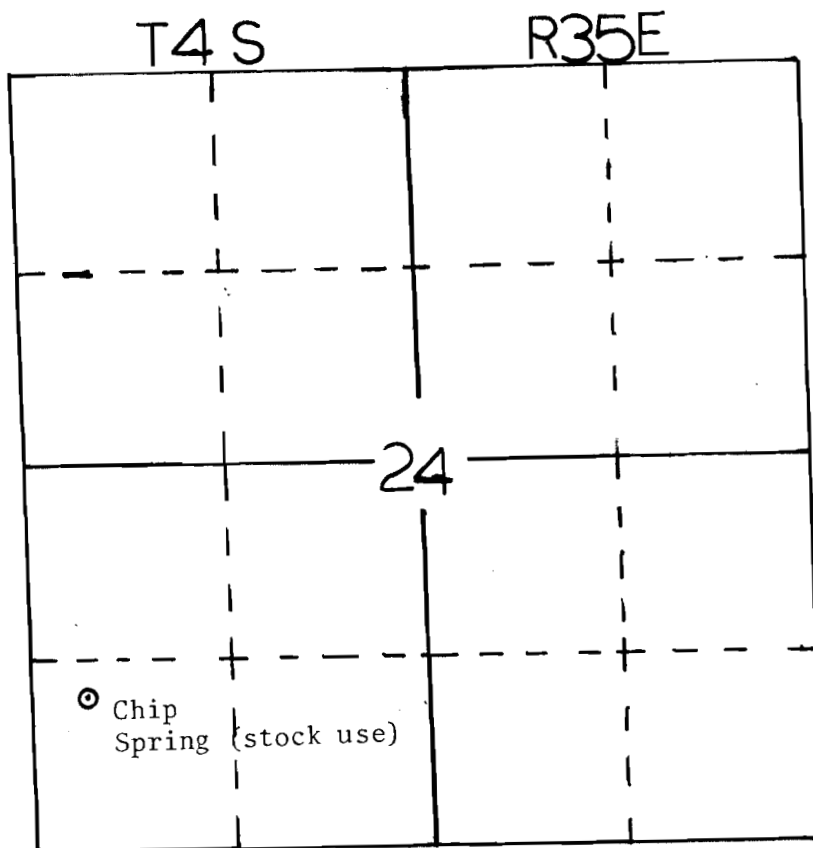

RECEIVED
MAR 21 1983
WATER RESOURCES DEPT. SALEM, OREGON

RECEIVED
SEP 10 1982
WATER RESOURCES DEPT. SALEM, OREGON

CHIP SPRING LOCATED: 1200 feet north and 250 feet east
from the SW corner of Section 24