


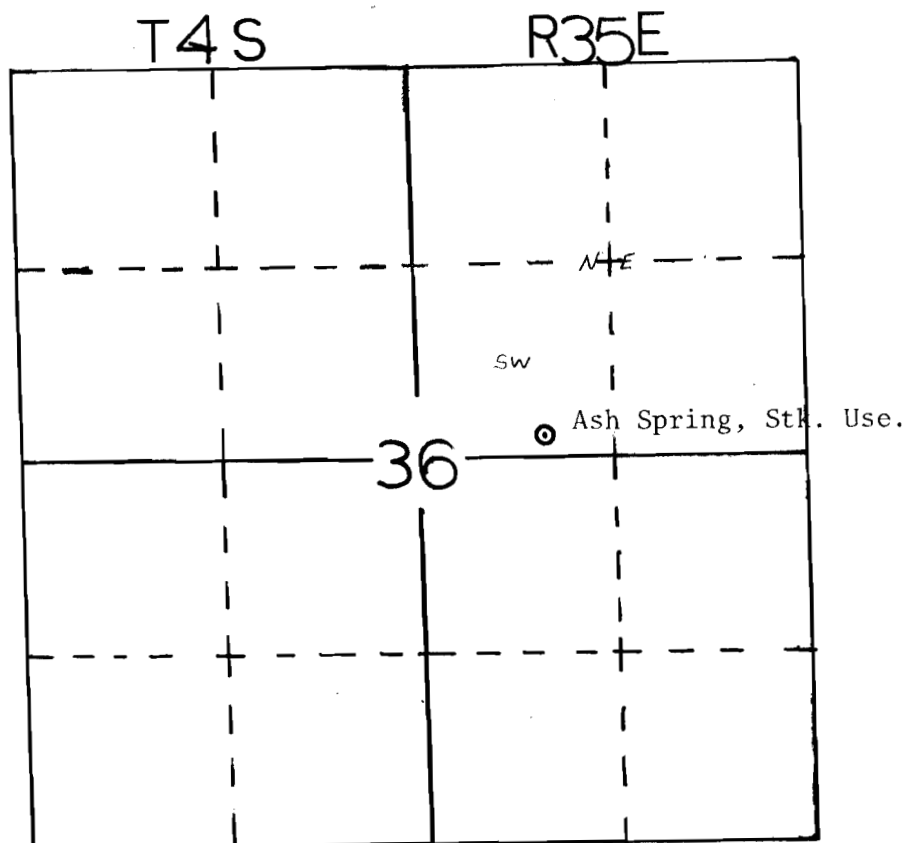

Ash Spring Located: 2508 feet South and 1782 feet West from the NE corner Sec. 36

RECEIVED

MAR 21 1983

WATER RESOURCES DEPT.
SALEM, OREGON

RECEIVED

SEP 10 1982

WATER RESOURCES DEPT.
SALEM, OREGON

Application No. 64139
Permit No. 48803

RECEIVED

APR 8 1983

WATER RESOURCES DEPT.
SALEM, OREGON