


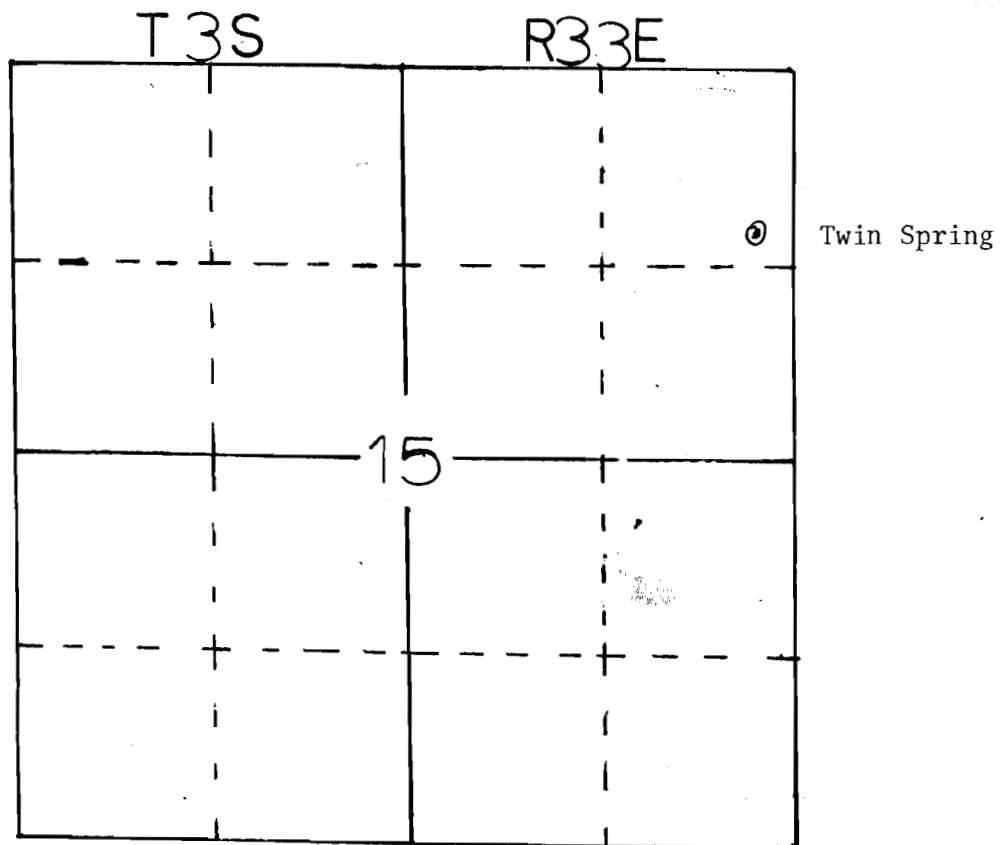

TWIN SPRING LOCATED: 1122 feet south and 264 feet west
from the NE corner of Section 15

Application No. 64140
Permit No. 48804

RECEIVED

SEP 10 1982

WATER RESOURCES DEPT.
SALEM, OREGON

RECEIVED

MAR 21 1983

WATER RESOURCES DEPT.
SALEM, OREGON