


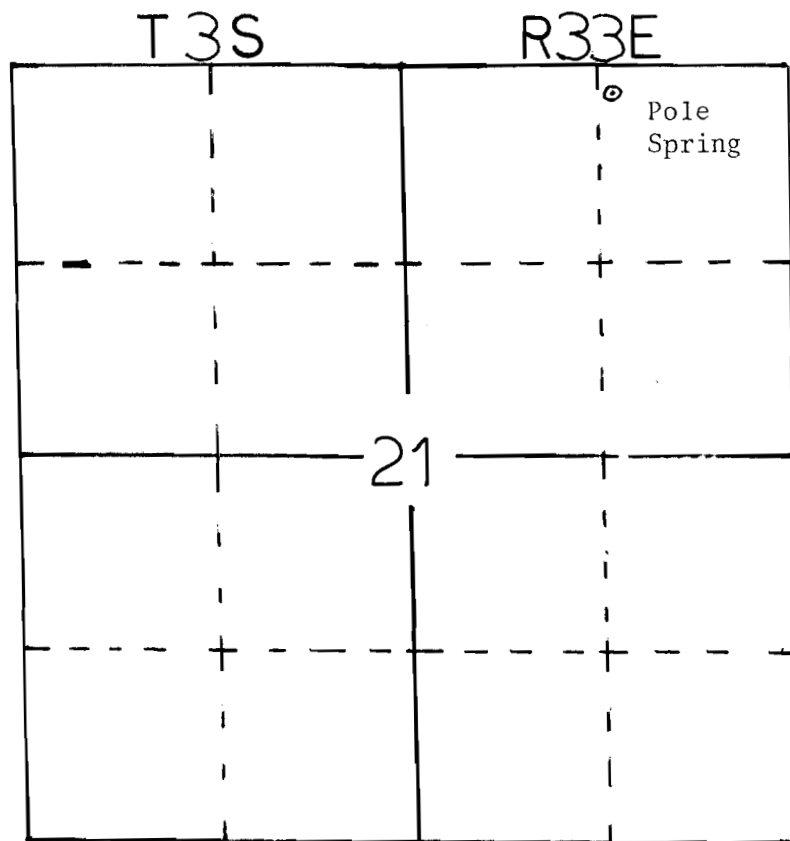

POLE SPRING LOCATED: 158 feet south and 1220 feet west from
the NE corner of section 21

Application No. 64141
Permit No. 48805

RECEIVED
SEP 10 1982
WATER RESOURCES DEPT.
SALEM, OREGON

RECEIVED
MAR 21 1983
WATER RESOURCES DEPT.
SALEM, OREGON